

FINAL REPORT

ON

THE CONSTRUCTION OF THE CANALIZATION FEATURE

of the

RIO GRANDE CANALIZATION PROJECT

BY

W. W. Baker  
Project Engineer

January 31, 1943

---



DEPARTMENT OF STATE  
INTERNATIONAL BOUNDARY COMMISSION  
UNITED STATES AND MEXICO  
UNITED STATES SECTION

REPORT ON THE CONSTRUCTION OF THE CANALIZATION FEATURE  
OF THE RIO GRANDE CANALIZATION PROJECT

1. INTRODUCTION

The engineering investigations of the Rio Grande between Caballo Dam, New Mexico and El Paso, Texas, the construction of the Canalization Project, the construction of the American Dam and Canal and the erection of the nine concrete river bridges were authorized by four Acts of Congress. These Acts were as follows:

(A) Public Resolution No. 4, First Session, 74th Congress, approved February 13, 1935<sup>(1)</sup>, authorizing the American Section of the International Boundary Commission, United States and Mexico, to conduct an engineering investigation and to make a report to the Secretary of State on the feasibility and best means for controlling and canalizing the Rio Grande from Caballo, N. M., to El Paso, Texas.

(B) Public Resolution No. 392, Act of August 29, 1935<sup>(2)</sup>, 74th Congress authorized the construction of the American Dam and Canal.

(C) Public Resolution No. 648, Act of June 4, 1936<sup>(3)</sup>, 74th Congress authorized the Canalizing of the Rio Grande from Caballo, New Mexico to El Paso, Texas.

- 
- (1) See Appendix - Exhibit A  
(2) See Appendix - Exhibit B  
(3) See Appendix - Exhibit C

(D) Public Resolution No. 472, Act of April 22, 1940(4), 76th Congress authorized the reconstruction of nine bridges over the Rio Grande in Dona Ana County, New Mexico and El Paso County, Texas.

The canalizing of the Rio Grande from Caballo Dam, New Mexico to El Paso, Texas authorized by these four Acts of Congress has been finished in accordance with these laws and the best engineering practices.

Final reports have been written and submitted to the Commissioner of the International Boundary Commission, United States Section, on all phases of this project other than the canalization works. This report relates the progress and construction of the canalization works with references to the preliminary investigations, the construction of the American Dam and Canal and the erection of the nine bridges over the Rio Grande river.

The main purpose for building all of these various works along the Rio Grande in New Mexico, and Texas, was to facilitate the United States Government in complying with the provisions of the Treaty with Mexico concluded May 21, 1906, providing for the equitable division of the waters of the Rio Grande and to regulate and control to the fullest extent the water supply for the two countries. The Canalization Project, by vesting a strip of right of way along the Rio Grande from El Paso to the Caballo Dam in the United States Government, by protecting the Valley lands from overflow during floods and by straightening the river channel, has provided the Government with the means to carry out the Treaty of May 21, 1906.

2. DESCRIPTION

The Rio Grande Canalization Project (1) extends 112 miles along the river from Caballo Dam, New Mexico to El Paso, Texas. It is located in the southerly part of Sierra County, New Mexico, extends completely across Dona Ana County, New Mexico, and reaches to the westerly limits of the city of El Paso in El Paso County, Texas. In general the project consists of a long narrow flood channel confined by two, more or less, parallel levees approximately seven hundred feet apart. In the center of this flood channel, the normal low flow channel is situated. Its purpose is to carry the normal irrigation requirements of the Rio Grande Reclamation Project. The capacity of the flood channel varies from 22,000 cubic feet per second in the vicinity of the Hatch-Rincon Railroad Bridge to 12,000 cubic feet per second near El Paso. The capacity of the normal channel is approximately 2,500 second feet.

3. WORK ACCOMPLISHED

Construction work on the project commenced on February 23, 1938 in the vicinity of the Santo Tomas Bridge with a crew of laborers clearing right of way.

Excavation operations began on July 6, 1938 when Dragline No. 4 commenced building the West Levee, approximately two miles above the Country Club Bridge in El Paso County, Texas.

---

(1) See Appendix - Exhibit G

During the five years since January 1938, project construction forces have cleared and grubbed 3,446.42 acres of land, moved 13,241,059 cubic yards of earthwork, installed 73.37 miles of fence revetment in the river channel, constructed 136 bridges, culverts and other small structures, leveled 3,296.28 acres of land on the floodways and built 125.92 miles of levees. This work was all performed by Government crews with Government owned equipment at unit prices comparable to large contract jobs. The cost of the canalization project, as of January 31, 1943, including the American Dam and Canal was \$3,890,744.12. The cost of the canalization feature was \$2,996,052.11.

A summary of the volume of work performed is shown in TABLE I. The overall cost of the project excluding the cost of the river bridges is as shown on page 6.

#### 4. PRELIMINARY INVESTIGATIONS

The preliminary investigations of the Rio Grande, from the Caballo Dam to El Paso, began April 13, 1935 and were completed on December 15, 1935. The engineering field and office work, the studies of flood conditions, the value to be gained by controlling the river and the preliminary plans and estimates of cost were summarized and compiled into the "Final Report - Control and Canalization of the Rio Grande, Caballo Dam site, New Mexico to Courchesene Bridge at El Paso".

The report emphasizes the need for the control of the river by the United States Government in order to comply with and regulate the diversion of waters to Mexico as required by the convention of 1906. It outlines the investigation work accomplished, explains the plans for the control of the river by means of a flood channel, normal flow channel and levees and shows the estimated cost of the project.

The field engineering surveys consisted of a closed traverse along both banks of the river from El Paso to the Caballo Dam, a line of bench levels and numerous topographical surveys. The preliminary surveys were used during construction for checking elevations, the alignment of levees and property lines.

The capacities of the flood channel, the method of computing the flood water elevations and the aerial photographs of the valley, all of which were made during the preliminary investigations and summarized in the "Final Report", were used as a basis for planning and designing the finished project.

##### 5. CONSTRUCTION

Headquarters: Headquarters for construction and maintenance work in the Mesilla Valley were located on south Melendres Street in Las Cruces. They consisted of a 2.50 acre storage yard, engineering office, clerical office, warehouse, shop and car shed. The headquarters were built in the first six months of 1938 and cost \$13,224.93.

The Rincon Valley headquarters was located about two miles north of Hatch, New Mexico, on U.S. Highway 85, near the bridge across the river. It contains about 5.00 acres of land, and the layout there is similar in construction to the Las Cruces yards. The buildings are a combination shop and warehouse, a dwelling house for the Maintenance Foreman, a garage and several sheds. The clerical building was moved from the Las Cruces yard to the Hatch yard in July 1941. This layout cost \$26,972.45.

Plan and Method: The plan of construction work followed was to build generally upstream, beginning at the El Paso Electric Light Plant and working toward the Caballo Dam. This plan had several advantages. It provided early flood protection to the valley lands in the lower reaches of the project, gave more time to study and design the channel in the upper and more difficult reaches of the valley, and formulated construction methods.

The method of construction varied from the plan proposed in the original report in that suction dredges were not used. The difficulty in moving a suction dredge past the numerous river bridges and the variations in the low flow of the river throughout the year were the deciding factors against the dredge proposed. The principal method employed was to build the levees with draglines from borrow pits and then to fill the pits with bulldozers or carryalls securing the earthwork from higher ground on the floodway or the river channel. However

this method was not universally employed. In many sections the levees were built entirely with carryalls borrowing earthwork from the floodways, river channel or cut-offs. Some cut-offs were built entirely by tractors and carryalls.

Equipment: The principal items of equipment employed on the construction work were as follows:

1 - P. & H. Dragline	3 Cu. Yd. Bucket, 110" boom
1 - Bucyrus-Erie Dragline, Model 111	3 " " " 105" "
2 - P. & H. Draglines, Model 750 Special	2 " " " 60" "
2 - P. & H. Draglines, Model 944	2 " " " 70" "
1 - Convertable P. & H. Dragline and Shovel, Model 355	3/4 " " " 40" "
4 - R.D. 8 and D. 8 Caterpillar Tractors	
2 - Model F-D Cletrac Tractors	
2 - L.D. Allis-Chalmers Tractors	
2 - S.O. Allis-Chalmers Tractors	
2 - T.D. 40, International Tractors	
3 - 12 Cubic yard capacity carryalls	
2 - 8 Cubic yard capacity carryalls	
2 - Caterpillar motor graders	
1 - Austin-Western Motor Grader	
1 - Electric Welder (Portable)	
1 - Complete Well point system- Jetting pump, pump & 60 well points	
1 - Air compressor (portable)	
4 - Tractor Mowers	
1 - 1/2 cubic yard concrete mixer	
3 - Small concrete mixers	
1 - 1000 Gal. capacity tank sprinkling truck	
1 - 1500 Gal. capacity tank sprinkling truck	
1 - I.H.C. 3 Ton Dump Truck	
1 - I.H.C. 3 Ton Stake Body Truck with winch	
1 - I.H.C. 2 Ton Stake Body Truck with winch	
11 - Passenger cars	
7 - Station wagons	
9 - 1/2 Ton Pick-up trucks	
2 - 1 Ton Light trucks	
2 - Jetting pumps (force pumps)	
6 - 100 Gallon per minute Centrifugal pumps	

The equipment cost about \$339,736.97 all of which has been depreciated into project construction costs.



Organization: The schedule of construction work mapped out proposed the completion of work in the Mesilla Valley before doing any work but surveying in the Rincon Valley. Therefore the crews, organization and equipment used in the Mesilla Valley were transferred to Hatch for work in the Rincon Valley after work was completed between Leasburg Dam and the El Paso Electric Light Plant. The construction and engineering organization throughout the construction period was approximately as shown on the attached Organization Chart for the first three years of construction work. It varied somewhat from this general chart due to the kind of work being performed and the equipment employed. When clearing operations were underway more laborers were employed and as excavation operations increased more men were employed in the shop and on the tractors and draglines.

The draglines, except machine No. 10, and tractors were operated two shifts each day with repair and service crews taking care of the machinery on the third shift. The mechanical shop also worked two shifts and for awhile an electric welder worked on the third shift. This method of operation kept the equipment in a better state of repair and produced a greater volume of earthwork each month. The carpenter, revetment and clearing crews worked only on the day shift.

Clearing and Grubbing Right of Way: As previously stated the clearing of right of way commenced near the Santo Tomas Bridge in the

RIO GRANDE CANALIZATION PROJECT  
ORGANIZATION CHART

September 30, 1940

PROJECT ENGINEER

FIELD ENGINEER
1 - Junior Engineer
1 - Engineering Aid
3 - Chiefs of Party
1 - Instrumentman
1 - Junior Engineer
1 - Engineering Aid
5 - Rodmen
1 - Chainman
1 - Apprentice Chainman
1 - Truck Driver
5 - Laborers
1 - Apprentice Rodman

OFFICE ENGINEER
4 - Junior Engineers
1 - Chief Draftsman
1 - Senior Draftsman
3 - Junior Draftsmen
1 - Right of way Clerk
1 - Stenographer
1 - Rodman
1 - Apprentice Rodman

CONSTRUCTION SUP'T.
7 - Chief Operating Engineers
3 - Construction Foremen
3 - Squad Foremen
5 - Truck Drivers
6 - Junior Guards
4 - Operator-Dragline
16 - Oper.-Tractor over 60 H.P.
3 - Oper.-Motor Grader
2 - Oper.-Tractor under 60 H.P.
14 - Oilers-Dragline
16 - Semi-skilled laborers
113 - Laborers

CHIEF CLERK
1 - Clerk
1 - Assistant Clerk
2 - Under Clerks
1 - Stenographer
1 - Ass't. Property & Supply Clerk
1 - Jr. Property & Supply Clerk
3 - Junior Guards
1 - Laborer

MECHANICAL SUP'T.
2 - Shop Foremen
1 - Truck Driver
6 - Mechanics
3 - Welders
10 - Handymen-Automotive
3 - Helpers-Mechanic
1 - Truck Helper
1 - Laborer

Total Number Project Employees 272  
Gross Payroll Earnings \$29,150.28

Mesilla Valley on February 23, 1938. This clearing was done by hand with axes and grub hoes. The crew was large, the foreman green at the job and the area cleared during the first few months small. A second crew employing about the same number of men and tools started work on the Zack White farm near the Country Club Bridge in March of 1938. As the cost of the work was high under this method and tractor equipment became available, each crew was supplemented with an International Harvester T.D. 40 Tractor. The tractor was used to pull or knock down the larger trees and the hand labor employed in cutting the smaller brush. A shop-made grubber was built and hooked on the T.D. 40 in place of the bulldozer blade. These worked well, however, the tractors were not powerful enough to root out the larger trees. To overcome this objection two large R.D. 8 Caterpillar tractors were purchased equipped with winches. The bulldozer was replaced with a revised shop-made grubber and the tractors put to work. The D-8 Caterpillar with the grubber attached was a highly successful piece of equipment for clearing and grubbing. They did all the heavy clearing.

These labor crews and these tractors were employed below the Mesilla Dam. Above the Mesilla Dam in the Mesilla Valley, also in the Rincon Valley, only one labor crew was employed. Right of way clearing and grubbing was finished on February 25, 1942.

The cost of clearing and grubbing in the four features is as follows:

<u>Feature</u>	<u>Acres</u>	<u>Total Cost</u>	<u>Cost per acre</u>
101	831.55	\$ 42,053.64	\$50.57
201	867.85	39,139.70	45.10
301	986.49	35,139.50	35.62
401	<u>760.53</u>	<u>30,005.66</u>	<u>39.45</u>
Total	3,446.62	\$146,338.50	\$42.46
<u>Re-Clearing</u>			
101	50.07	304.76	6.09
201	273.89	2,716.62	9.92
301	19.38	98.60	5.09
401	<u>137.69</u>	<u>667.96</u>	<u>4.85</u>
Total	481.03	\$3,787.94	\$7.87
<u>Total Re-clearing &amp; Clearing</u>	3927.45	\$150,126.44	\$38.22

Revetment Installations: In order to straighten the low flow channel of the river, protect sharp bends from erosion and to confine the river to a well defined channel varying in width from 150 feet to 300 feet, it was necessary to use some form of river training jetties or revetment. This revetment took the form of a woven wire fence with the front face located on the proposed low flow channel banks and cross-fences or back fences connecting this front line back to the established banks of the river. The purpose of the back or cross-fences was to slow down the velocity of the current and to protect the banks from erosion. The slower current caused silt to deposit and form additional floodway.

The fence was constructed of creosoted piling 5" to 8" in diameter from 16 feet to 22 feet long and spaced from 15 feet to 30 feet apart depending on the river condition at the site of installation. A heavy cable and woven wire fence was stretched along the line of piles. The piles were set usually about three to three and one half feet above the low water surface of the river. The piling were all jettied into place with powerful jetting pumps and work was usually done during the low water season. A typical installation and layout is pictured on the next page. See Plan No. 3223-48.

The revetment construction was stronger, the piles spaced closer together and heavier cable used on all work in the Rincon Valley. The first installations in the upper valley, built according to Mesilla Valley standards, were not able to withstand the flood conditions occurring in that reach of the project. The heavier fence was built due to this situation.

The construction crews employed to install the revetment usually consisted of a foreman, one revetment placer, two or three revetment helpers, a pump operator and about twenty laborers. This crew under normal conditions could jet from forty to fifty piles in place and stretch the woven wire on about 1000 feet of piling in a day. They used a powerful pressure pump with two nozzles or jets to wash the holes out for the piles. As a rule the revetment program was carried on during the winter time, however, during other periods it was often necessary to work to prevent bank erosion.

The amount installed during the five years of construction was 387,376 linear feet, or 73.37 miles. The cost and location is summarized as follows:

<u>Feature</u>	<u>Linear Feet</u>	<u>Cost</u>	<u>Cost per foot</u>
101	51,380	\$ 29,180.96	.5679
201	97,005	46,086.22	.4751
301	105,817	59,300.22	.5604
401	<u>133,174</u>	<u>89,501.51</u>	<u>.6721</u>
Total	387,376	224,068.61	.5784

Excavation and Embankment: The building of the levees, excavation of the river cut-offs and the grading of the floodways of the project were all performed by the tractors and carryalls. In many locations the material had to be rehandled by the draglines to place it in the desired levee location. A great deal of long distance hauling of earthwork was done with the tractors pulling a carryall. The material excavated from the river channel cut-offs was placed in the levees or moved upstream or downstream into lower ground. This hauling was done by the carryalls.

In many instances only sandy material was available for levee construction. In these cases clay had to be hauled for some distances to plat the slopes and crowns of the levees to prevent blowing and to make a serviceable embankment.

There were seven draglines, twelve tractors, five carryalls, three motor graders and a large number of 3-cubic-yard capacity dump trucks employed on the excavation operations. The volume of earthwork moved by this equipment is shown in all reports as 13,241,059

cubic yards. Many changes in plans and improvements to the finished job are always made where work is performed by force account which increases the quantities materially. Usually in order to get a true picture of the quantities moved, accurate surveys are required. On force account jobs, unless there is a very good reason for performing such surveys, the quantities are estimated and generally under estimated. On the canalization project it is, therefore, believed the equipment moved large volumes of earthwork without credit in quantities. The floodways were leveled and sloped from the levee toe to the river channel by the tractors. The tractors were given credit for this work by acres under floodway leveling. This sloping and leveling required the moving of a large volume of earthwork. In many instances considerable drifting of earthwork was done; that is moving the higher ground on the floodway to lower ground either upstream or downstream. The volume of such work was difficult to ascertain and in all probability a greater quantity was moved by the machines than they were allowed. A rough estimate is that 30% more earthwork was moved than shown in the reports.

The equipment listed in previous pages of this report for moving earthwork were all employed on construction operations in the Mesilla Valley. Due to the lighter and more scattered work in the Rincon Valley and to the cost of moving, Draglines No. 5 and 6 were not used on that reach of the project. They are heavy slow machines and in order to

produce economically, require heavy concentrations of earthwork. No work of this nature was available in the Rincon Valley. The following items of work were constructed by all equipment:

Excavation and embankment	13,241,059 cu. yds.
Levee	125.92 miles
Floodway leveled	3296.28 acres
Channel cut-offs	10.00 miles

The periods of construction for the various features of the project are as follows:

<u>Feature</u>	<u>Work Began</u>	<u>Work Completed</u>
101	July 6, 1938	December 18, 1939
201	August 1, 1938	July 1, 1940
301	October 14, 1939	March 20, 1941
401	July 15, 1940	July 1, 1942
501	April 1, 1942	February 15, 1943

TABLES II and III are a summary of the dragline and tractor operations.

Levee Surfacing: The levees throughout the project were surfaced with selected pit run gravel. This material varied from pit to pit depending on the gravel, amount of clay binder and gradation of the gravel in each borrow area. The material was screened and tested by an inspector and if more binder was needed the shovel was moved to clay material, if the gravel was too coarse the shovel operator was again directed to move to a section of the pit where the material came nearer to complying with the specified sizes.

The gravel was loaded by shovel No. 10 into 3-cubic-yard capacity rented dump trucks. They delivered the material to the levee



where it was processed, sprinkled and spread. Two motor graders and three 1000 gallon to 1500-gallon capacity sprinkling trucks were employed in the spreading and wetting operations. Between twenty-five and thirty-five dump trucks were contracted by the Government at an hourly rate for hauling the material to the levees.

Gravel pits were located along the foot hills throughout the project at intervals of about 15 miles. These pits were accessible to the main highways and roads leading to the levees and very few haul distances were over fifteen miles. The quantity of gravel hauled, the cost and unit costs are as follows:

	FEATURE			
	101	201	301	401
Miles	27.16	36.62	30.19	31.95
Quantity Placed	48,389	80,631	59,726	90,442
Cu. Yds. per Station	33.7	41.7	37.5	55.0
Thickness	6"	6"	6"	6"
Cost per Cu. Yd.	.6132	.5711	.5267	.4972
Cost per mile	\$ 1,092.47	\$ 1,257.42	\$ 1,042.08	\$ 1,407.51
Total Cost	\$29,671.51	46,047.05	31,460.28	44,969.96

SUMMARY OF MECHANICAL ANALYSIS

Percent Retained		FEATURE			
		101	201	301	401
Oversize	2"	.76	0	0	2.2
Rock	1/4"	41.2	35.9	35.9	44.7
Fines	No. 8	49.8	47.3	50.5	55.1
Clay-Sand	No. 200	88.8	88.7	88.6	79.6
Binder Passing	200 mesh	11.2	11.3	11.4	20.4

Arroyo Diversions: Two large arroyos, the Jaralosa and the Crow draining a large area south of the Rio Grande empty into the river south of Garfield, New Mexico. They both, according to various estimates, discharge from 15,000 second feet to 20,000 second feet of water. In 1935 the Crow ran heavily, filled the river channel with silt, rock and debris and flooded several hundred acres of valuable farm lands on the north side of the river. As the canalization channel was menaced by the probability of frequent occurrences of similar floods, plans were developed diverting these arroyos into areas where they could do little damage to the channel and deposit silt for many years without harming project works.

The Jaralosa was diverted northeasterly into a low-lying bosque area of about 125 acres through a channel 50 feet on the bottom. This channel has a capacity of 2,300 second feet at a four foot depth of water. The grade of the channel is  $S = .0065$  and it was assumed it would wash larger during floods.

The Crow arroyo was diverted to the east into another large bosque area of about 200 acres through a channel 25 feet on the bottom with a grade of  $S = .003$ . It was again assumed the channel would cut itself out during floods. The floods in these arroyos during the summer of 1942 cut and scoured the channels considerably over the constructed size. The location of these diversions is shown on Alignment Maps No. 29 and 30.

Structures: The structures on the canalization project were all small. They consisted of 20-ton capacity treated-timber bridges, a few 4' x 4' concrete box culverts with gates to control the backwater, 48", 36", 30" and 24" diameter concrete pipe culverts with automatic drainage gates on the outlet ends, a few corrugated pipe culverts and a number of small timber irrigation structures built in relocated laterals.

The main structures were located in the levees at their intersection with the Reclamation wasteways and drain outlets. Generally bridges were built over the drains and main wasteways where larger water openings were required and the banks of the drain or wasteway built up to prevent flooding of adjacent farm lands by backwater during high floods in the river. The concrete pipe culverts were used on the smaller wasteways and provided with an automatic drainage gate to prevent flooding of lands by backwater.

As the structures were small and scattered up and down the valley they were all built by one small structure crew. Generally the dewatering system was required to build the culverts as the grade of all were below the level of the water table. The piles on the timber bridges were jettied into place rather than being driven. Most of the piling had a penetration of from eight to ten feet.

A summary of the structures built are as follows:

Treated Timber Bridges - all types	29
Concrete Pipe Culverts	49



Major Concrete Structures	}	5
Drops - 4'x4' Box Culverts - Special		
48" Diam. Concrete Pipes		
Corrugated Metal Culverts, 24", 30" and 42"		5
Timber and concrete checks and turnouts		46
Cattle guards		2


River Bridge Work: The specifications and contract with Keliher Construction Company for the construction of the nine river bridges specified that the removal of the old bridges and the building of the approaches to the new bridges would be done by the Government.

The demolition of the old bridges and the building of the new approaches was usually done at the same time. Generally the floor of the bridge and the superstructure were taken off with a winch truck and a group of laborers. The piling were broken off at the bed of the river, or a foot or so below by pulling with a D-8 Caterpillar tractor.

Care was taken to save as much of the good timber as possible, however, the bridges were old, rotten and not much good timber could be salvaged. In all cases the steel trusses were salvaged in reasonably good shape. The total cost of removing the nine old bridges was \$2,788.50, an average of \$309.80 per bridge. The earthwork cost \$3,721.17 for 22,600 cubic yards at 16 $\frac{1}{2}$  cents per cubic yard. The cost to the Government for each bridge for removal and the building of the approaches was \$723.60.

INTERNATIONAL BOUNDARY COMMISSION  
 UNITED STATES AND MEXICO  
 UNITED STATES SECTION  
 MAP OF THE  
 RIO GRANDE CANALIZATION PROJECT

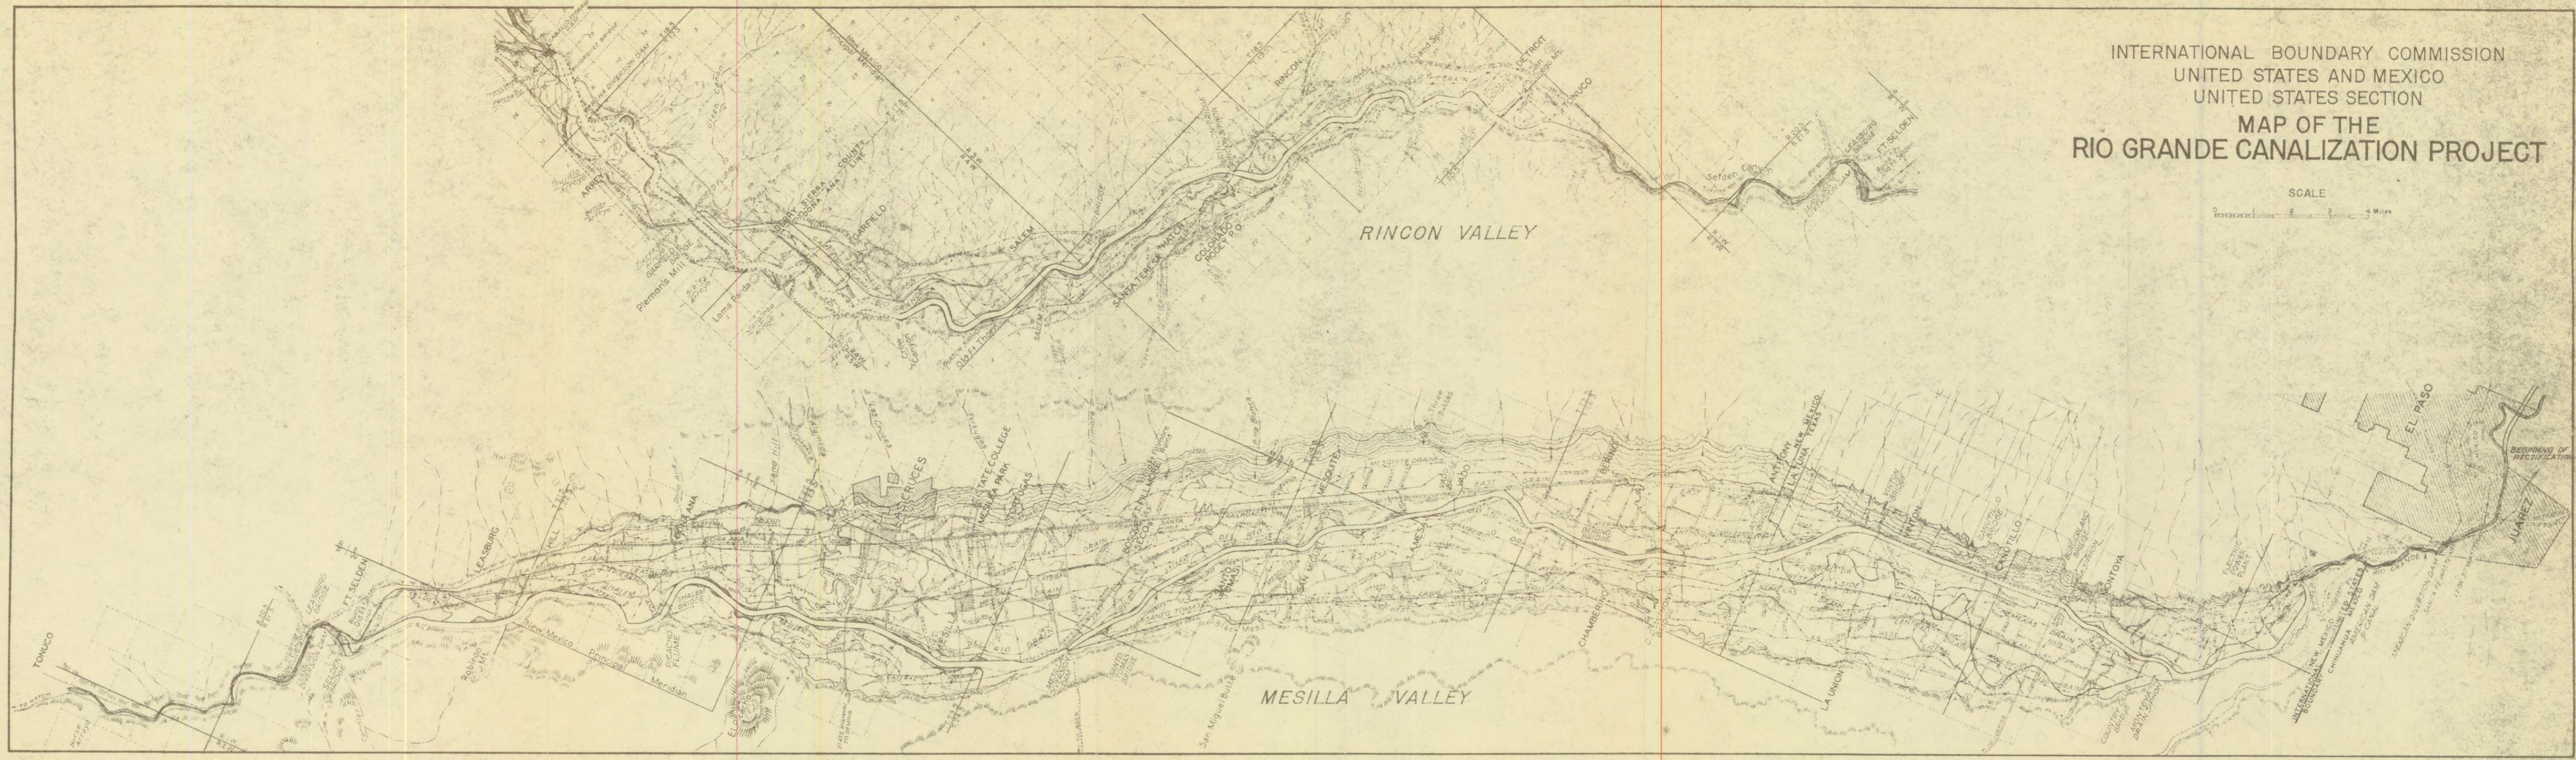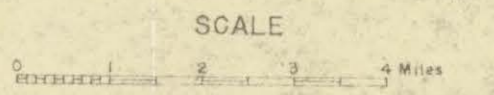

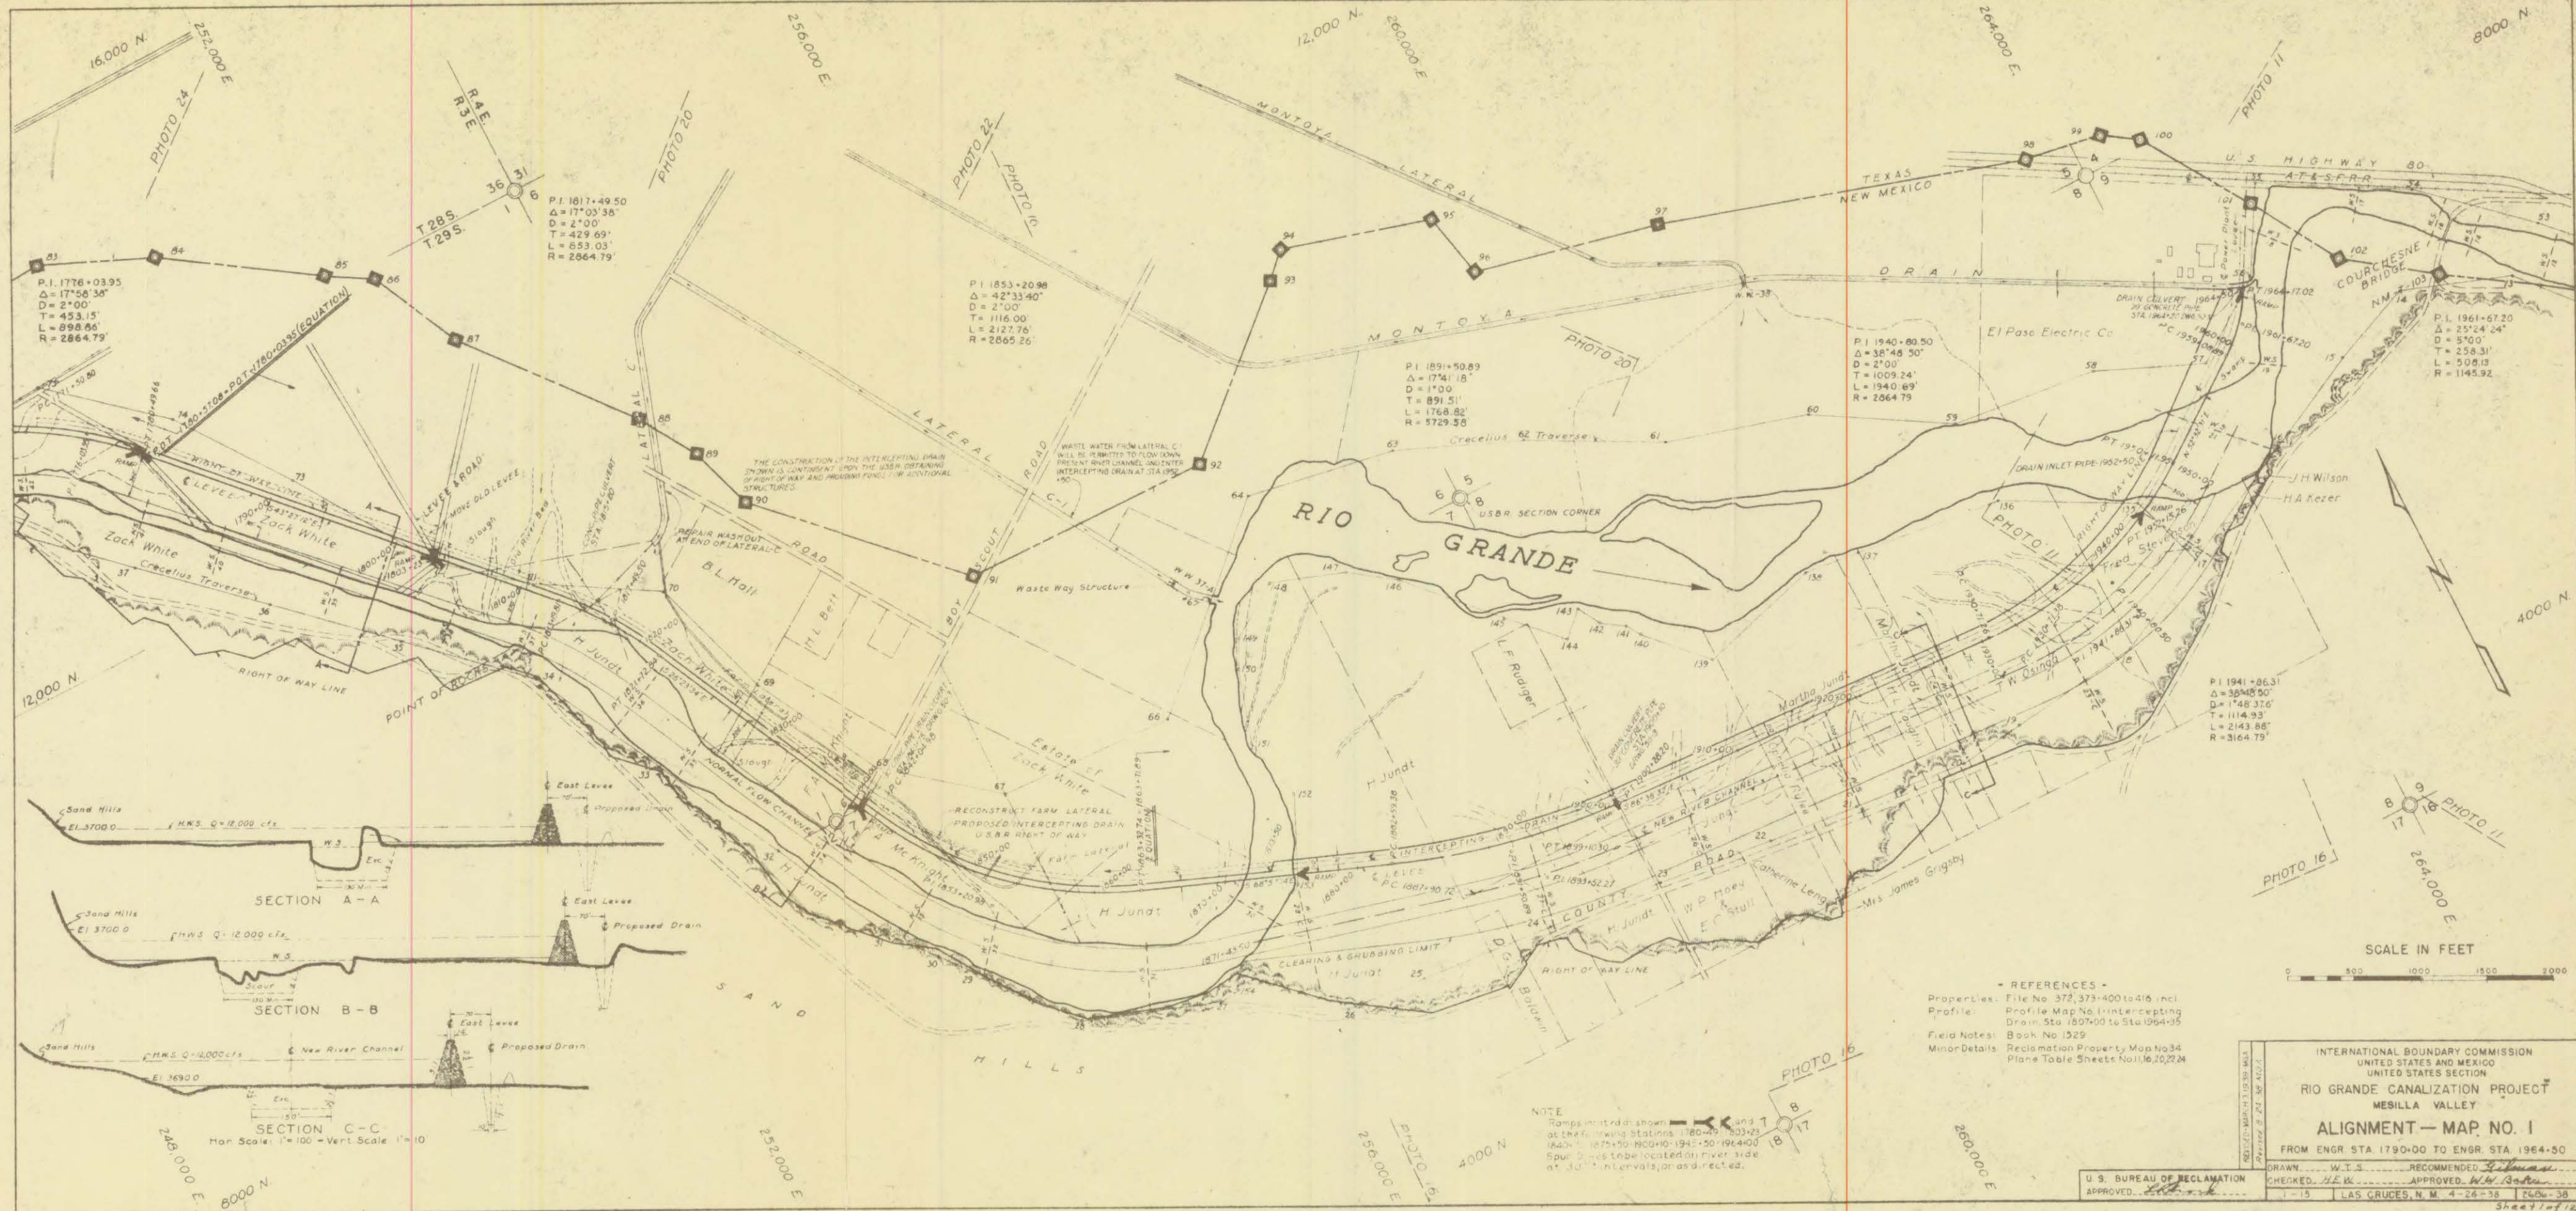

P.I. 1776+03.95  
 $\Delta = 17^{\circ}03'36''$   
 $D = 2^{\circ}00'$   
 $T = 453.15'$   
 $L = 898.86'$   
 $R = 2864.79'$

P.I. 1817+49.50  
 $\Delta = 17^{\circ}03'36''$   
 $D = 2^{\circ}00'$   
 $T = 429.69'$   
 $L = 853.03'$   
 $R = 2864.79'$




P.I. 1853+20.98  
 $\Delta = 42^{\circ}33'40''$   
 $D = 2^{\circ}00'$   
 $T = 1116.00'$   
 $L = 2127.76'$   
 $R = 2865.26'$

P.I. 1891+50.89  
 $\Delta = 17^{\circ}41'18''$   
 $D = 1^{\circ}00'$   
 $T = 891.51'$   
 $L = 1768.82'$   
 $R = 5729.58'$

P.I. 1940+80.50  
 $\Delta = 38^{\circ}48'50''$   
 $D = 2^{\circ}00'$   
 $T = 1009.24'$   
 $L = 1940.69'$   
 $R = 2864.79'$

P.I. 1961+67.20  
 $\Delta = 25^{\circ}24'24''$   
 $D = 5^{\circ}00'$   
 $T = 258.31'$   
 $L = 508.13'$   
 $R = 1145.92'$

P.I. 1941+86.31  
 $\Delta = 38^{\circ}48'50''$   
 $D = 1^{\circ}48'37''$   
 $T = 1114.93'$   
 $L = 2143.88'$   
 $R = 3164.79'$

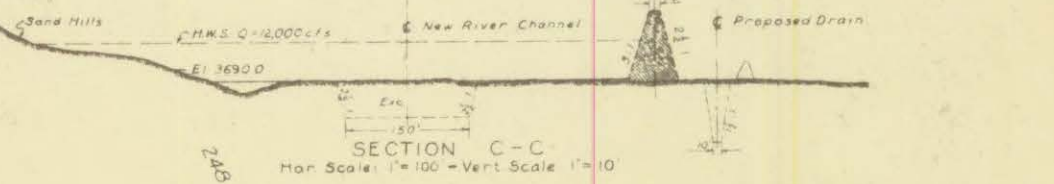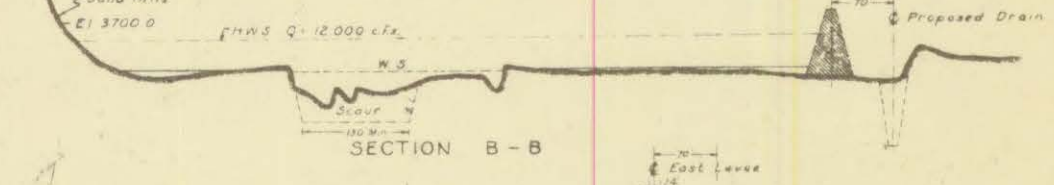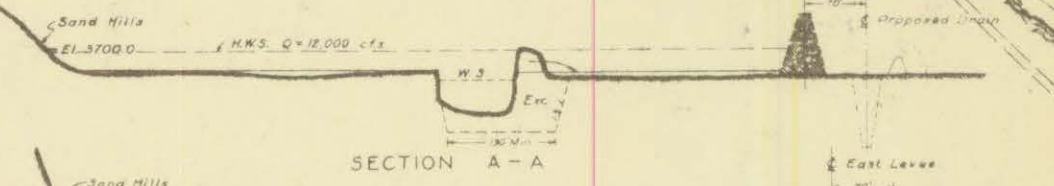

- REFERENCES**
- Properties: File No. 372,373-400 to 416 incl.
  - Profile: Profile Map No. 1 (Intercepting Drain, Sta. 1807+00 to Sta. 1964+35)
  - Field Notes: Book No. 1329
  - Minor Details: Reclamation Property Map No. 34, Plane Table Sheets No. 11, 16, 20, 22, 24


**NOTE**  
 Ramps located as shown by dashed lines and T at the following stations: 1780+49, 1803+23, 1840+10, 1875+50, 1900+10, 1945+50, 1964+00. Spur Dimes to be located on river side at 30' intervals, as directed.

INTERNATIONAL BOUNDARY COMMISSION  
 UNITED STATES AND MEXICO  
 UNITED STATES SECTION

**RIO GRANDE CANALIZATION PROJECT**  
 MESILLA VALLEY

**ALIGNMENT—MAP NO. 1**  
 FROM ENGR. STA. 1790+00 TO ENGR. STA. 1964+50

U.S. BUREAU OF RECLAMATION  
 DRAWN: W.T.S. RECOMMENDED: *[Signature]*  
 CHECKED: *[Signature]* APPROVED: *[Signature]*  
 1-15 LAS CRUCES, N.M. 4-24-38 76B-38  
 Sheet 1 of 12

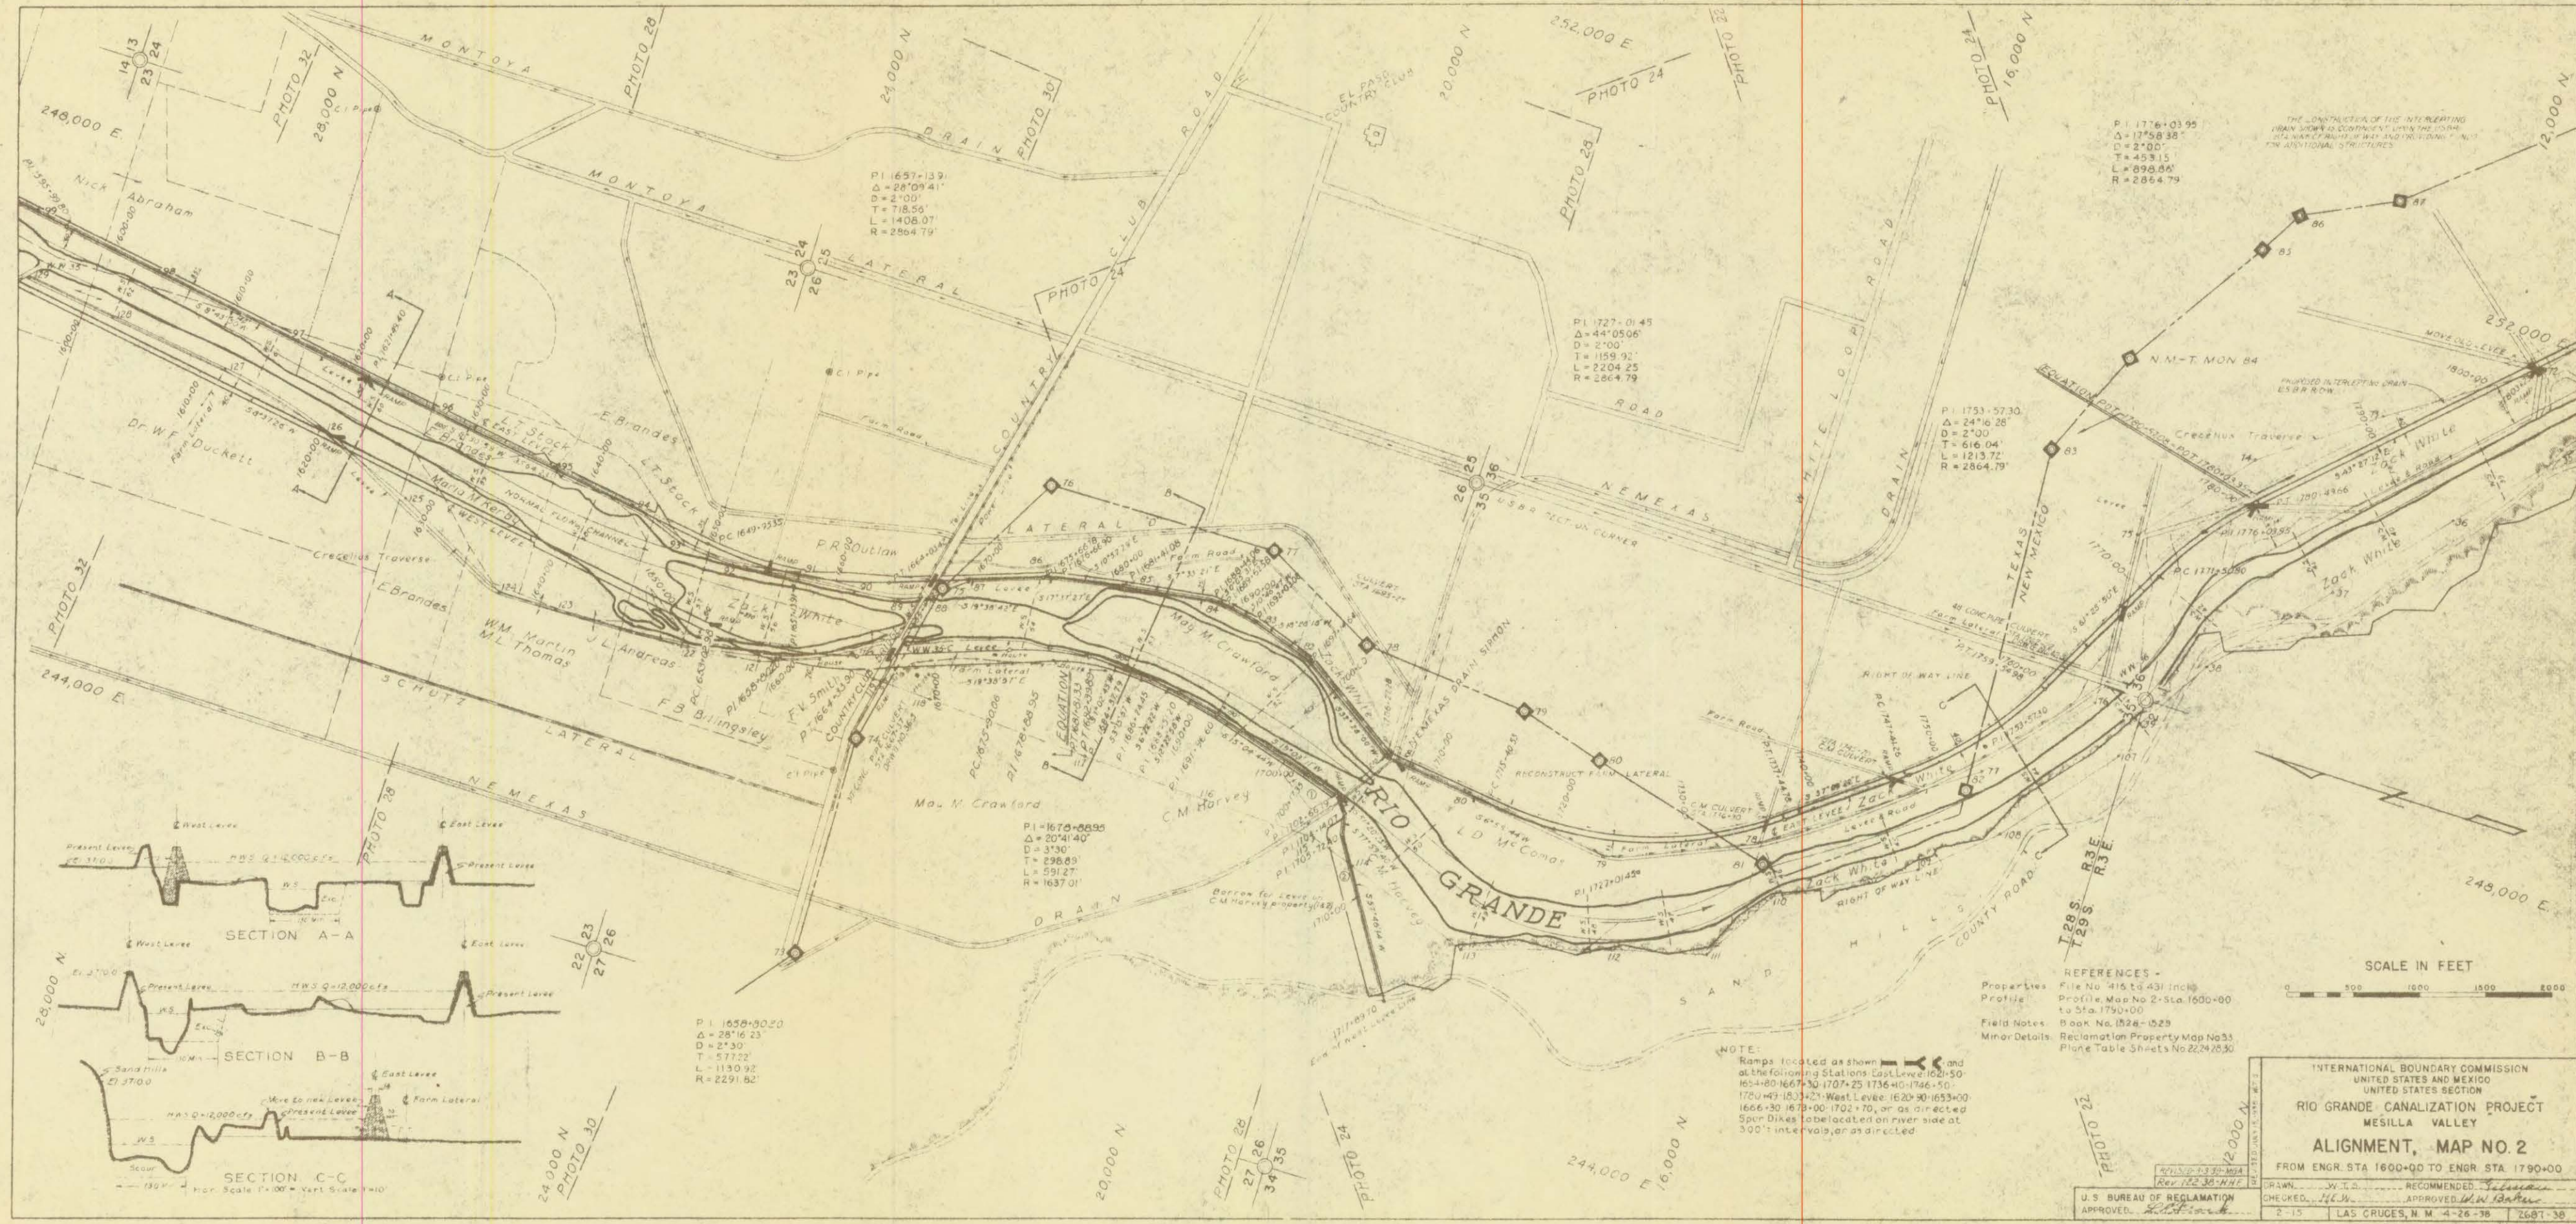

P1 1776-03 95  
 Δ = 17°58'38"  
 D = 2°00'  
 T = 453.15'  
 L = 898.86'  
 R = 2864.79'




P1 1657-13 91  
 Δ = 28°09'41"  
 D = 2°00'  
 T = 718.56'  
 L = 1408.07'  
 R = 2864.79'

P1 1727-01 45  
 Δ = 44°05'06"  
 D = 2°00'  
 T = 1159.92'  
 L = 2204.25'  
 R = 2864.79'


P1 1753-57 30  
 Δ = 24°16'28"  
 D = 2°00'  
 T = 616.04'  
 L = 1213.72'  
 R = 2864.79'

P1 1675-08 95  
 Δ = 20°41'40"  
 D = 3°30'  
 T = 298.89'  
 L = 591.27'  
 R = 1637.01'

P1 1658-00 20  
 Δ = 28°16'23"  
 D = 2°30'  
 T = 577.22'  
 L = 1130.92'  
 R = 2291.82'

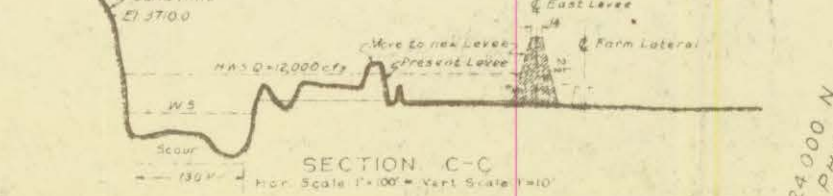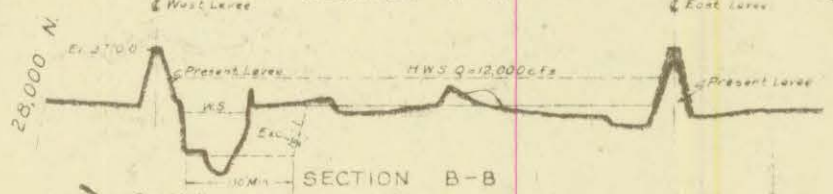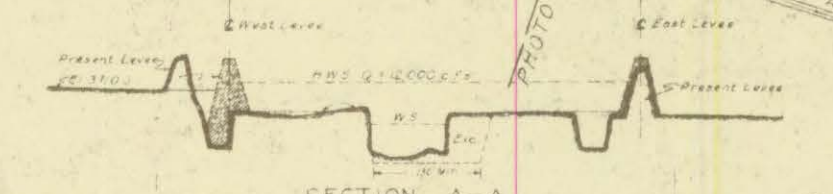


REFERENCES -  
 Properties: File No. 415 to 431 Incls.  
 Profile: Profile Map No. 2-Sta. 1600+00 to Sta. 1790+00  
 Field Notes: Book No. 1524-1529  
 Minor Details: Reclamation Property Map No. 53  
 Plane Table Sheets No. 22, 24, 25, 30

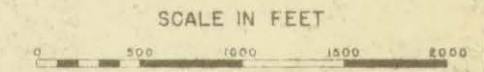


NOTE:  
 Ramps located as shown **IK** and at the following Stations: East Level: 1621+50-1654+80; 1666+30-1707+25; 1736+40-1746+50; 1720+49-1833+21; West Level: 1620+30-1653+00; 1666+30-1678+00; 1702+70, or as directed. Spur Dikes to be located on river side at 300' intervals, as directed.

INTERNATIONAL BOUNDARY COMMISSION  
 UNITED STATES AND MEXICO  
 UNITED STATES SECTION  
**RIO GRANDE CANALIZATION PROJECT**  
 MESILLA VALLEY  
**ALIGNMENT, MAP NO. 2**  
 FROM ENGR. STA. 1600+00 TO ENGR. STA. 1790+00

DRAWN: J.W.S. RECOMMENDED: [Signature]  
 CHECKED: [Signature] APPROVED: W.W. [Signature]  
 2-15 LAS CRUCES, N.M. 4-26-38 2687-38  
 Sheet 2 of 2

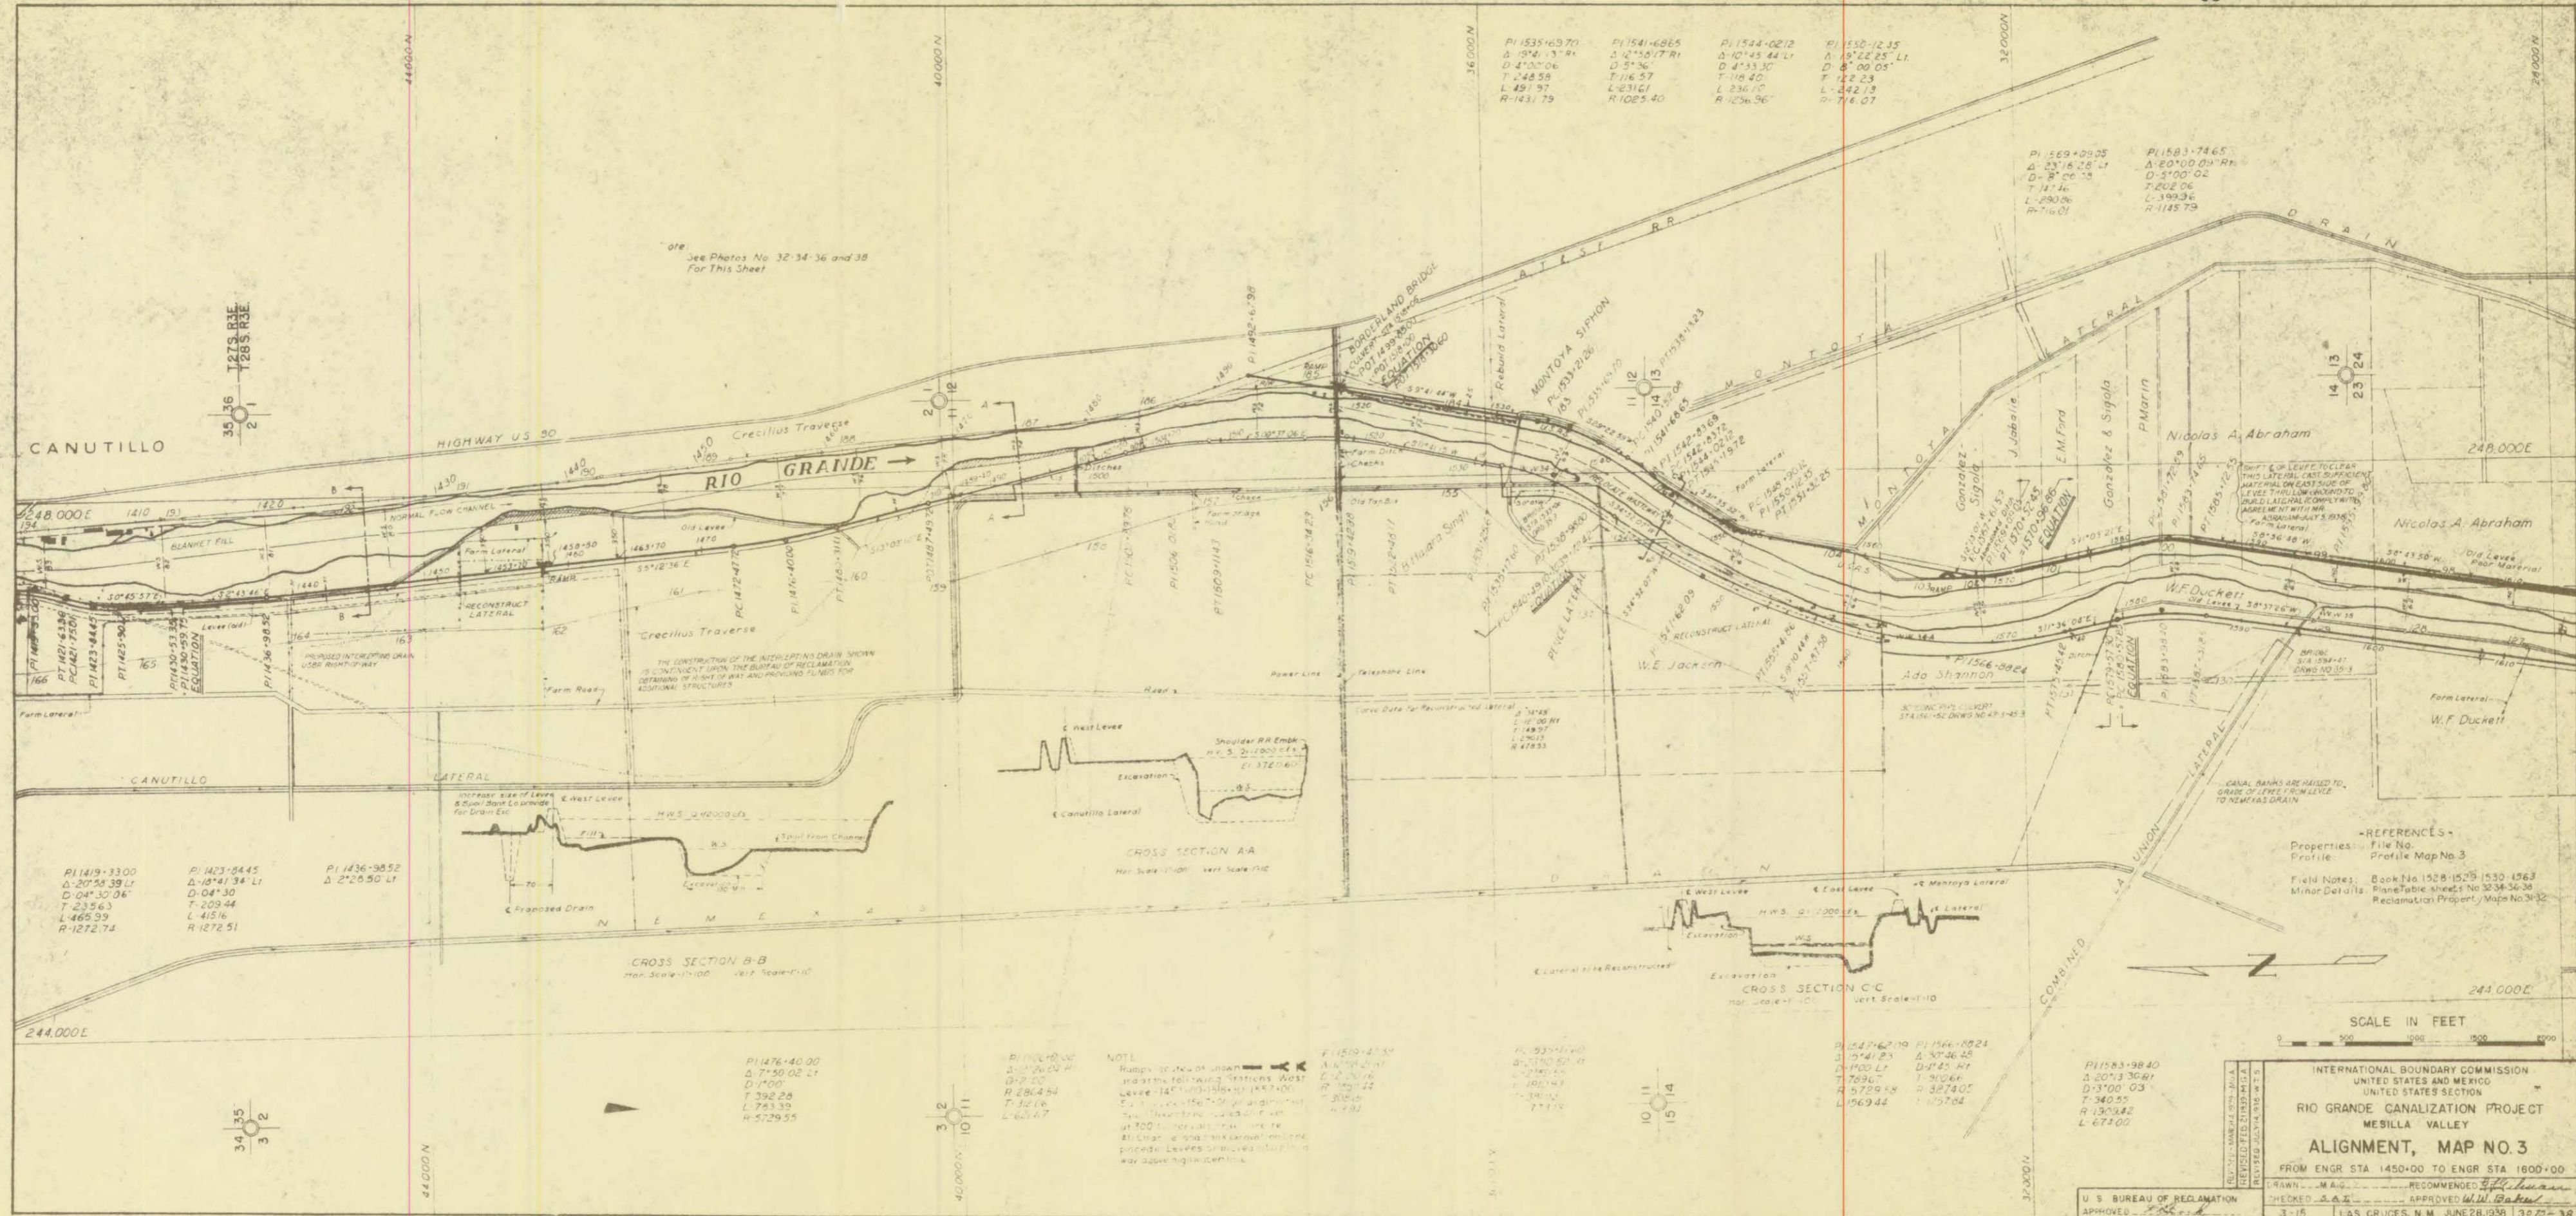

See Photos No. 32-34-36 and 38  
For This Sheet

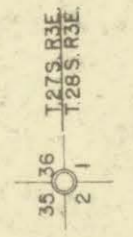

CANUTILLO

HIGHWAY US 90

RIO GRANDE

ATLATL RR

DRAIN

LATERAL

CROSS SECTION A-A  
Hor. Scale 1"=100' Vert. Scale 1"=10'

CROSS SECTION B-B  
Hor. Scale 1"=100' Vert. Scale 1"=10'

CROSS SECTION C-C  
Hor. Scale 1"=100' Vert. Scale 1"=10'

REFERENCES -  
Properties: File No. Profile Map No. 3  
Field Notes: Book No. 1528-1529-1530-1563  
Plan Tables: sheets No. 32-34-36-38  
Reclamation Property Maps No. 31-32

SCALE IN FEET  
0 500 1000 1500 2000

PI 1419+3300  
Δ 20° 58' 39" LI  
D 04' 30.06"  
T 235.63  
L 465.99  
R 1272.74

PI 1423+8445  
Δ 10° 41' 34" LI  
D 04' 30"  
T 209.44  
L 415.16  
R 1272.51

PI 1436+9852  
Δ 2° 26' 50" LI



44000' N

PI 1476+4000  
Δ 7° 50' 02" LI  
D 7' 00"  
T 392.28  
L 783.39  
R 5729.55

PI 1500+0000  
Δ 2° 26' 02" LI  
D 7' 00"  
T 392.28  
L 783.39  
R 5729.55

NOTE  
Rumpy scales of known  
used at the following stations: West  
Levee - 145+00 to 155+00  
E. Lateral - 155+00 to 160+00  
Montoya Lateral - 160+00 to 170+00  
Crecillus Traverse - 170+00 to 180+00  
Ditch - 180+00 to 190+00  
Farm Lateral - 190+00 to 200+00  
Power Line - 200+00 to 210+00  
Telephone Line - 210+00 to 220+00  
Road - 220+00 to 230+00  
Shoulder RR Embankment - 230+00 to 240+00  
Excavation - 240+00 to 250+00

PI 1519+4130  
Δ 10° 15' 44" LI  
D 4' 33.30"  
T 118.40  
L 236.10  
R 1025.40

PI 1535+69.70  
Δ 10° 15' 44" LI  
D 4' 33.30"  
T 118.40  
L 236.10  
R 1025.40

PI 1541+6865  
Δ 10° 15' 44" LI  
D 4' 33.30"  
T 118.40  
L 236.10  
R 1025.40

PI 1544+0212  
Δ 10° 15' 44" LI  
D 4' 33.30"  
T 118.40  
L 236.10  
R 1025.40

PI 1550+1235  
Δ 10° 15' 44" LI  
D 4' 33.30"  
T 118.40  
L 236.10  
R 1025.40



PI 1547+6200  
Δ 10° 15' 44" LI  
D 4' 33.30"  
T 118.40  
L 236.10  
R 1025.40

PI 1566+8024  
Δ 10° 15' 44" LI  
D 4' 33.30"  
T 118.40  
L 236.10  
R 1025.40

PI 1583+9840  
Δ 20° 58' 39" LI  
D 04' 30.06"  
T 235.63  
L 465.99  
R 1272.74

INTERNATIONAL BOUNDARY COMMISSION  
UNITED STATES AND MEXICO  
UNITED STATES SECTION

RIO GRANDE CANALIZATION PROJECT  
MESILLA VALLEY

ALIGNMENT, MAP NO. 3






FROM ENGR STA 1450+00 TO ENGR STA 1600+00

DRAWN BY M.A.G. RECOMMENDED BY J.L. BAKER  
CHECKED BY S.A. APPROVED BY W.W. BAKER

U.S. BUREAU OF RECLAMATION  
APPROVED: [Signature] 3-15 LAS CRUCES, N.M. JUNE 28, 1938 30.25-38

Sheet 5 of 12



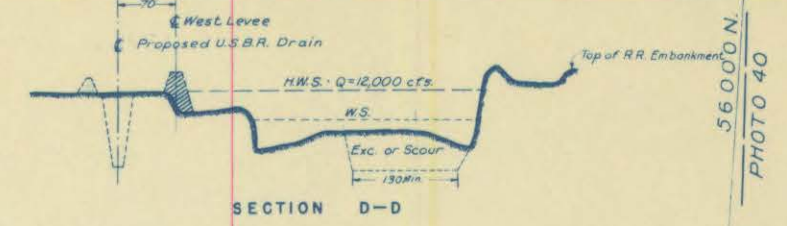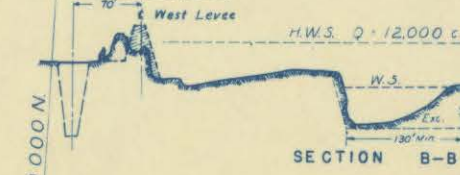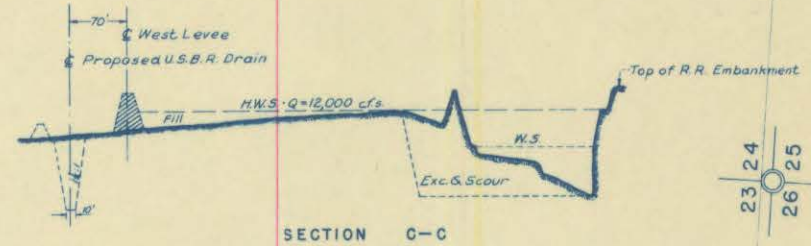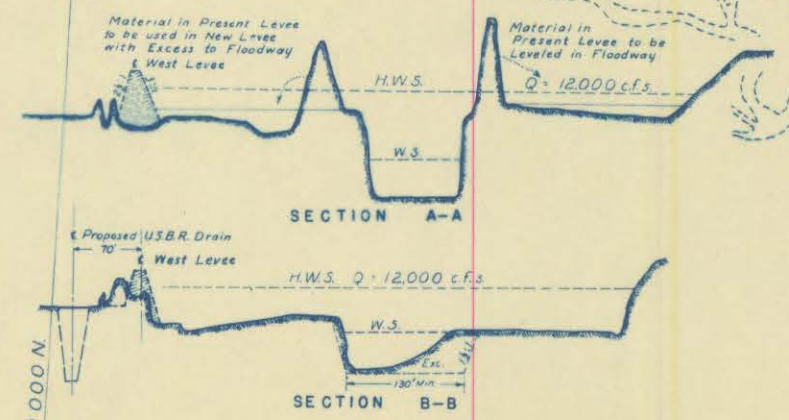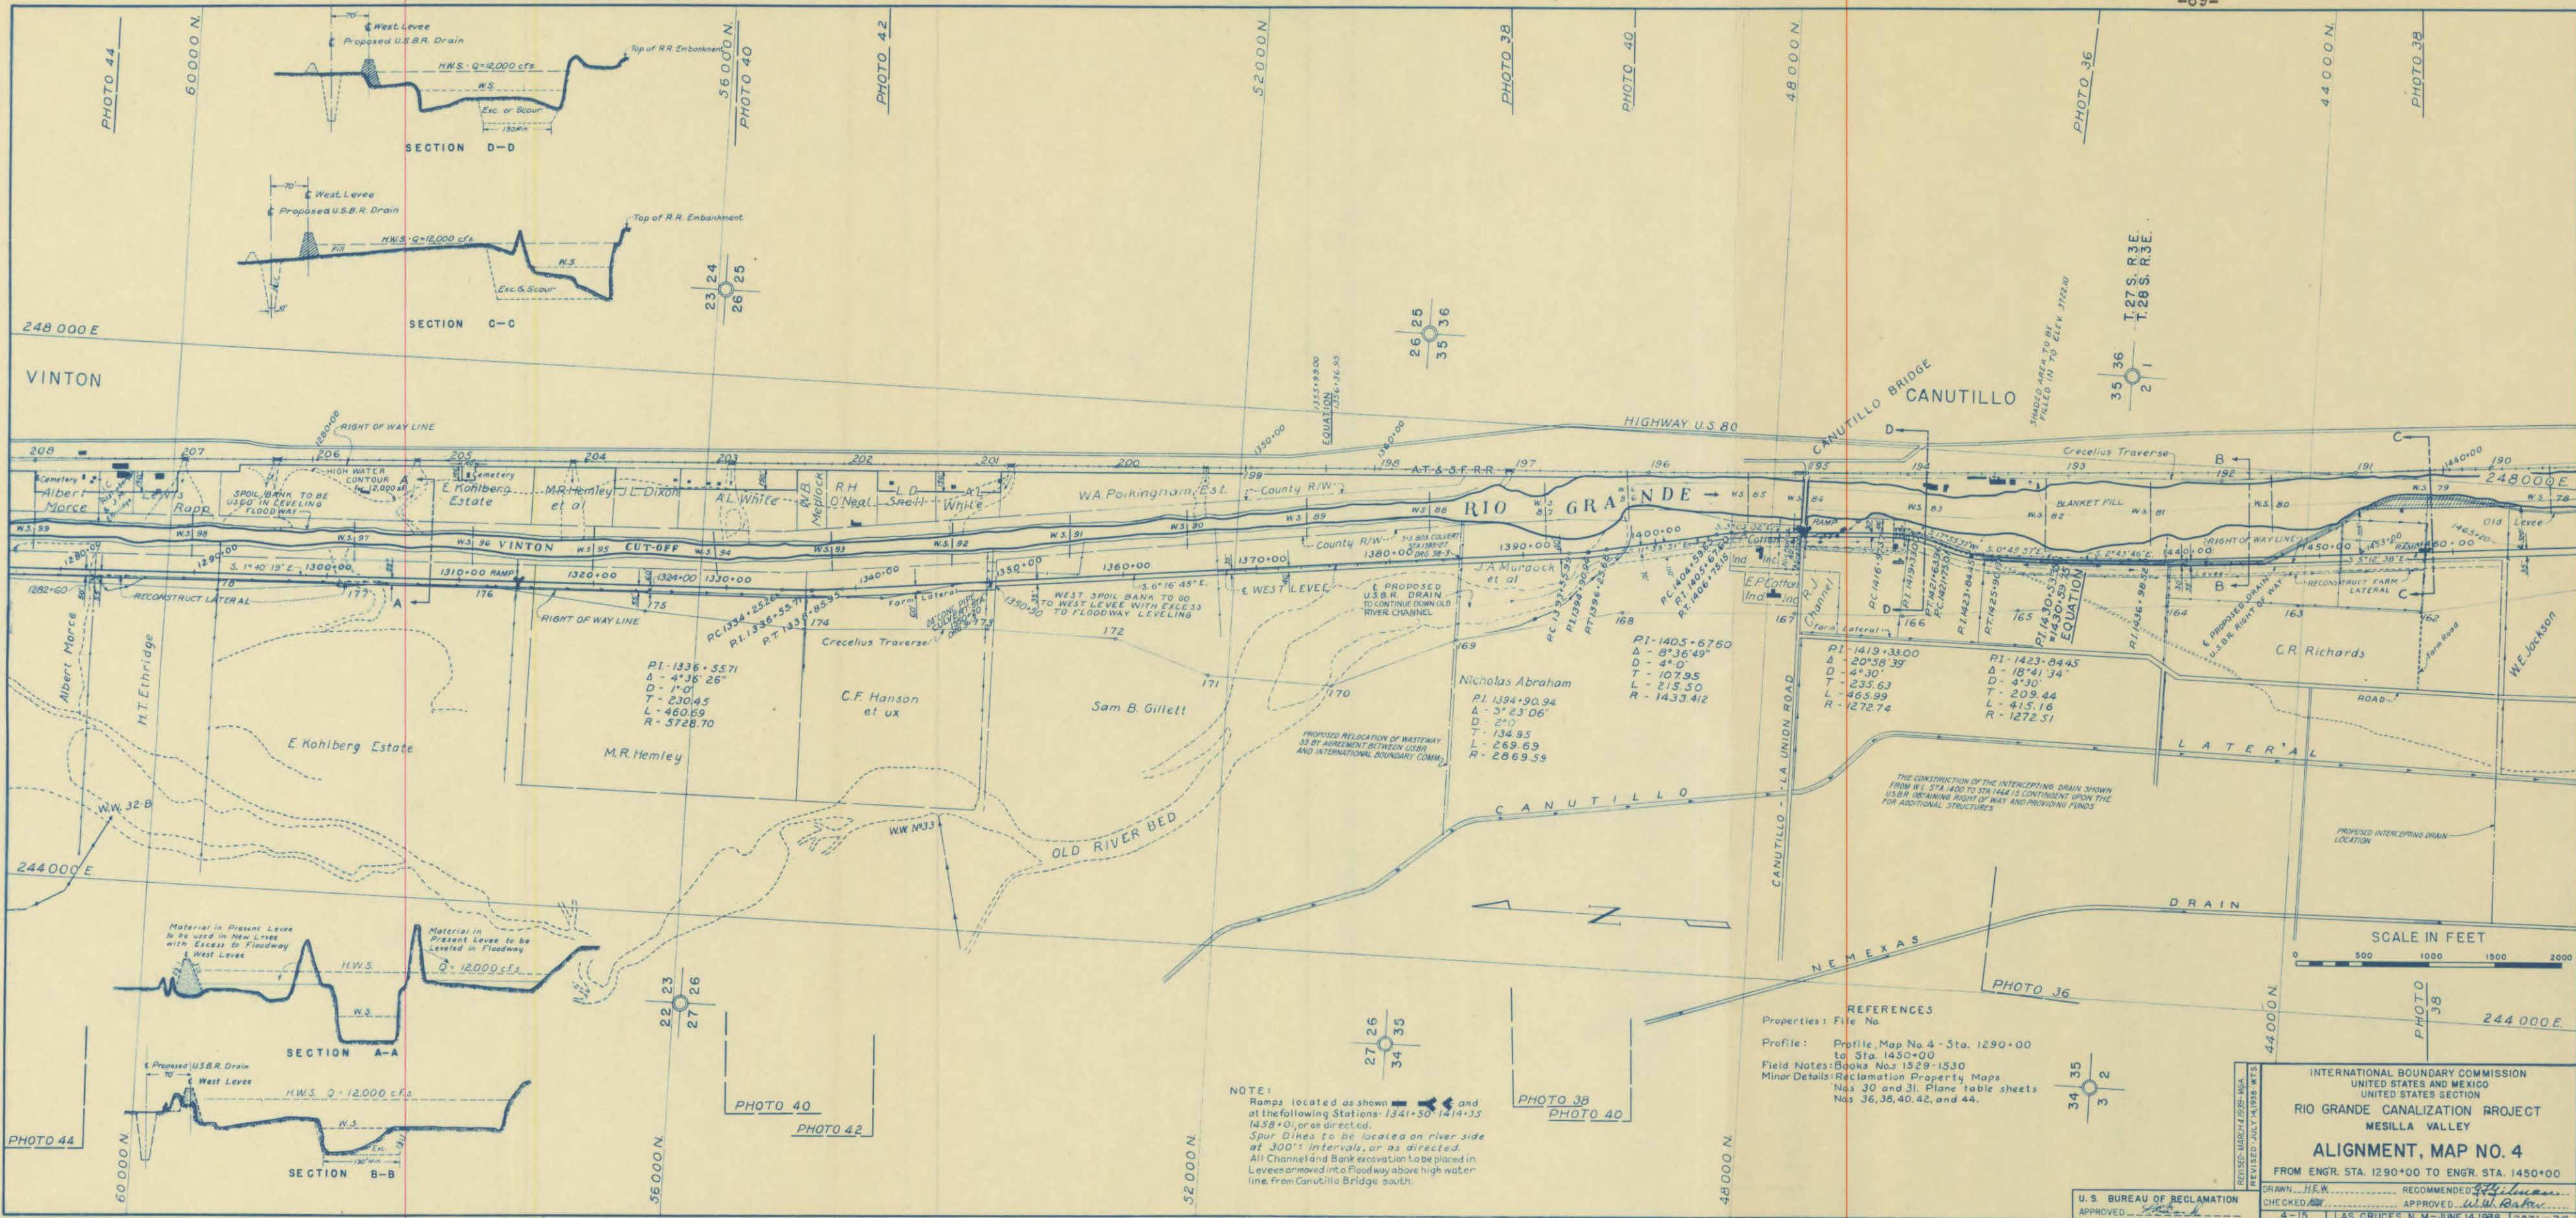


**NOTE:**  
 Ramps located as shown and at the following Stations: 1341+50, 1414+35, 1458+00, as directed.  
 Spur Dikes to be located on river side at 300' intervals, as directed.  
 All Channel and Bank excavation to be placed in Levees or moved into Floodway above high water line from Canutillo Bridge south.

**REFERENCES**  
 Properties: File No.  
 Profile: Profile, Map No. 4 - Sta. 1290+00 to Sta. 1450+00  
 Field Notes: Books Nos. 1529-1530  
 Minor Details: Reclamation Property Maps Nos. 30 and 31, Plane table sheets Nos. 36, 38, 40, 42, and 44.



INTERNATIONAL BOUNDARY COMMISSION  
 UNITED STATES AND MEXICO  
 UNITED STATES SECTION  
**RIO GRANDE CANALIZATION PROJECT**  
 MESILLA VALLEY  
**ALIGNMENT, MAP NO. 4**  
 FROM ENGR. STA. 1290+00 TO ENGR. STA. 1450+00

U.S. BUREAU OF RECLAMATION  
 APPROVED: [Signature]  
 DRAWN: H.E.W. RECOMMENDED: [Signature]  
 CHECKED: [Signature] APPROVED: [Signature]  
 4-15 LAS CRUCES, N. M. - JUNE 14, 1958 13071-38  
 Sheet 4 of 12

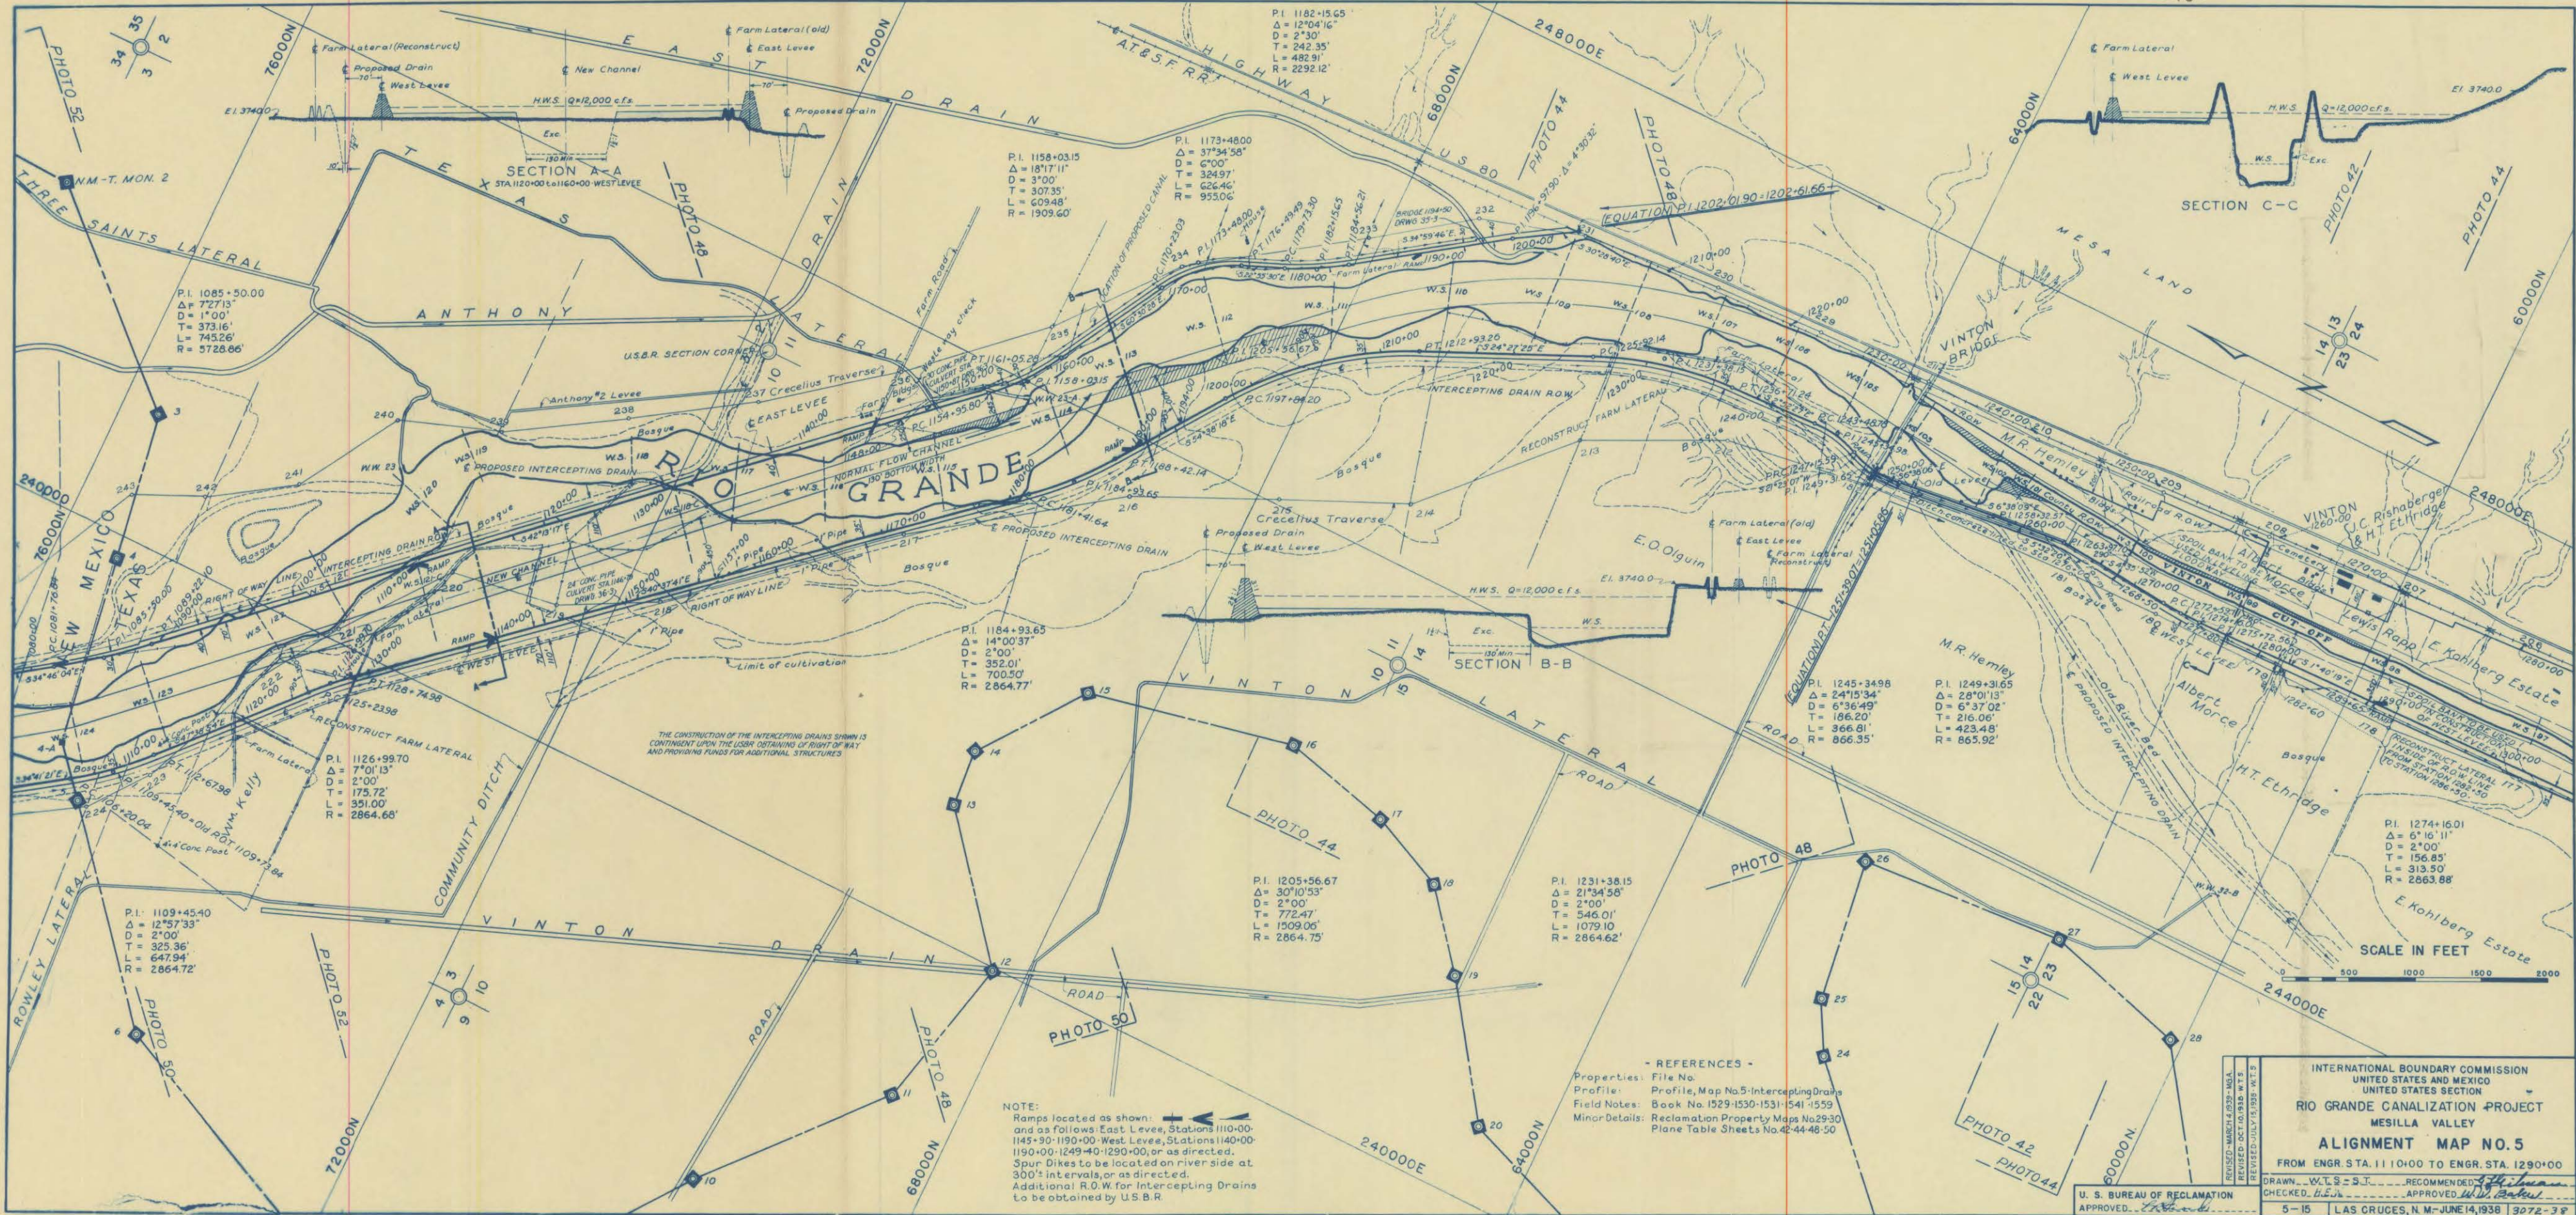

P.I. 1085+50.00  
 $\Delta = 7^{\circ}27'13''$   
 $D = 1^{\circ}00'$   
 $T = 373.16'$   
 $L = 7452.26'$   
 $R = 5726.66'$

P.I. 1158+03.15  
 $\Delta = 18^{\circ}17'11''$   
 $D = 3^{\circ}00'$   
 $T = 307.35'$   
 $L = 609.48'$   
 $R = 1909.60'$

P.I. 1173+48.00  
 $\Delta = 37^{\circ}34'58''$   
 $D = 6^{\circ}00'$   
 $T = 324.97'$   
 $L = 626.46'$   
 $R = 955.06'$

P.I. 1184+93.65  
 $\Delta = 14^{\circ}00'37''$   
 $D = 2^{\circ}00'$   
 $T = 352.01'$   
 $L = 700.50'$   
 $R = 2864.77'$

P.I. 1126+99.70  
 $\Delta = 7^{\circ}01'13''$   
 $D = 2^{\circ}00'$   
 $T = 175.72'$   
 $L = 351.00'$   
 $R = 2864.68'$

P.I. 1109+45.40  
 $\Delta = 12^{\circ}57'33''$   
 $D = 2^{\circ}00'$   
 $T = 325.36'$   
 $L = 647.94'$   
 $R = 2864.72'$

P.I. 1245+34.98  
 $\Delta = 24^{\circ}15'34''$   
 $D = 6^{\circ}36'49''$   
 $T = 186.20'$   
 $L = 366.81'$   
 $R = 866.35'$

P.I. 1249+31.65  
 $\Delta = 28^{\circ}01'13''$   
 $D = 6^{\circ}37'02''$   
 $T = 216.06'$   
 $L = 423.48'$   
 $R = 865.92'$

P.I. 1274+16.01  
 $\Delta = 6^{\circ}16'11''$   
 $D = 2^{\circ}00'$   
 $T = 156.85'$   
 $L = 313.50'$   
 $R = 2863.88'$

P.I. 1205+56.67  
 $\Delta = 30^{\circ}10'53''$   
 $D = 2^{\circ}00'$   
 $T = 772.47'$   
 $L = 1509.06'$   
 $R = 2864.75'$

P.I. 1231+38.15  
 $\Delta = 21^{\circ}34'58''$   
 $D = 2^{\circ}00'$   
 $T = 546.01'$   
 $L = 1079.10'$   
 $R = 2864.62'$

NOTE:  
 Ramps located as shown:  
 and as follows: East Levee, Stations 1110+00-1145+90-1190+00-West Levee, Stations 1140+00-1190+00-1249+40-1290+00, or as directed.  
 Spur Dikes to be located on river side at 300' intervals, or as directed.  
 Additional R.O.W. for Intercepting Drains to be obtained by U.S.B.R.

REFERENCES -  
 Properties: File No.  
 Profile: Profile, Map No. 5-Intercepting Drains  
 Field Notes: Book No. 1529-1530-1531-541-559  
 Minor Details: Reclamation Property Maps No. 29-30  
 Plane Table Sheets No. 42-44-48-50

INTERNATIONAL BOUNDARY COMMISSION  
 UNITED STATES AND MEXICO  
 UNITED STATES SECTION  
 RIO GRANDE CANALIZATION PROJECT  
 MESILLA VALLEY  
 ALIGNMENT MAP NO. 5  
 FROM ENGR. STA. 1110+00 TO ENGR. STA. 1290+00


REVISIONS:  
 REVISION NUMBER 1938-1938  
 REVISION DATE 08/01/38  
 REVISION BY W.L.S. W.L.S.

U. S. BUREAU OF RECLAMATION  
 APPROVED: *[Signature]*

DRAWN: W.L.S. - S.J. RECOMMENDED: *[Signature]*  
 CHECKED: *[Signature]* APPROVED: *[Signature]*

5-15 LAS CRUCES, N. M. - JUNE 14, 1938 3072-38  
 Sheet 5 of 12

SCALE IN FEET  
 0 500 1000 1500 2000

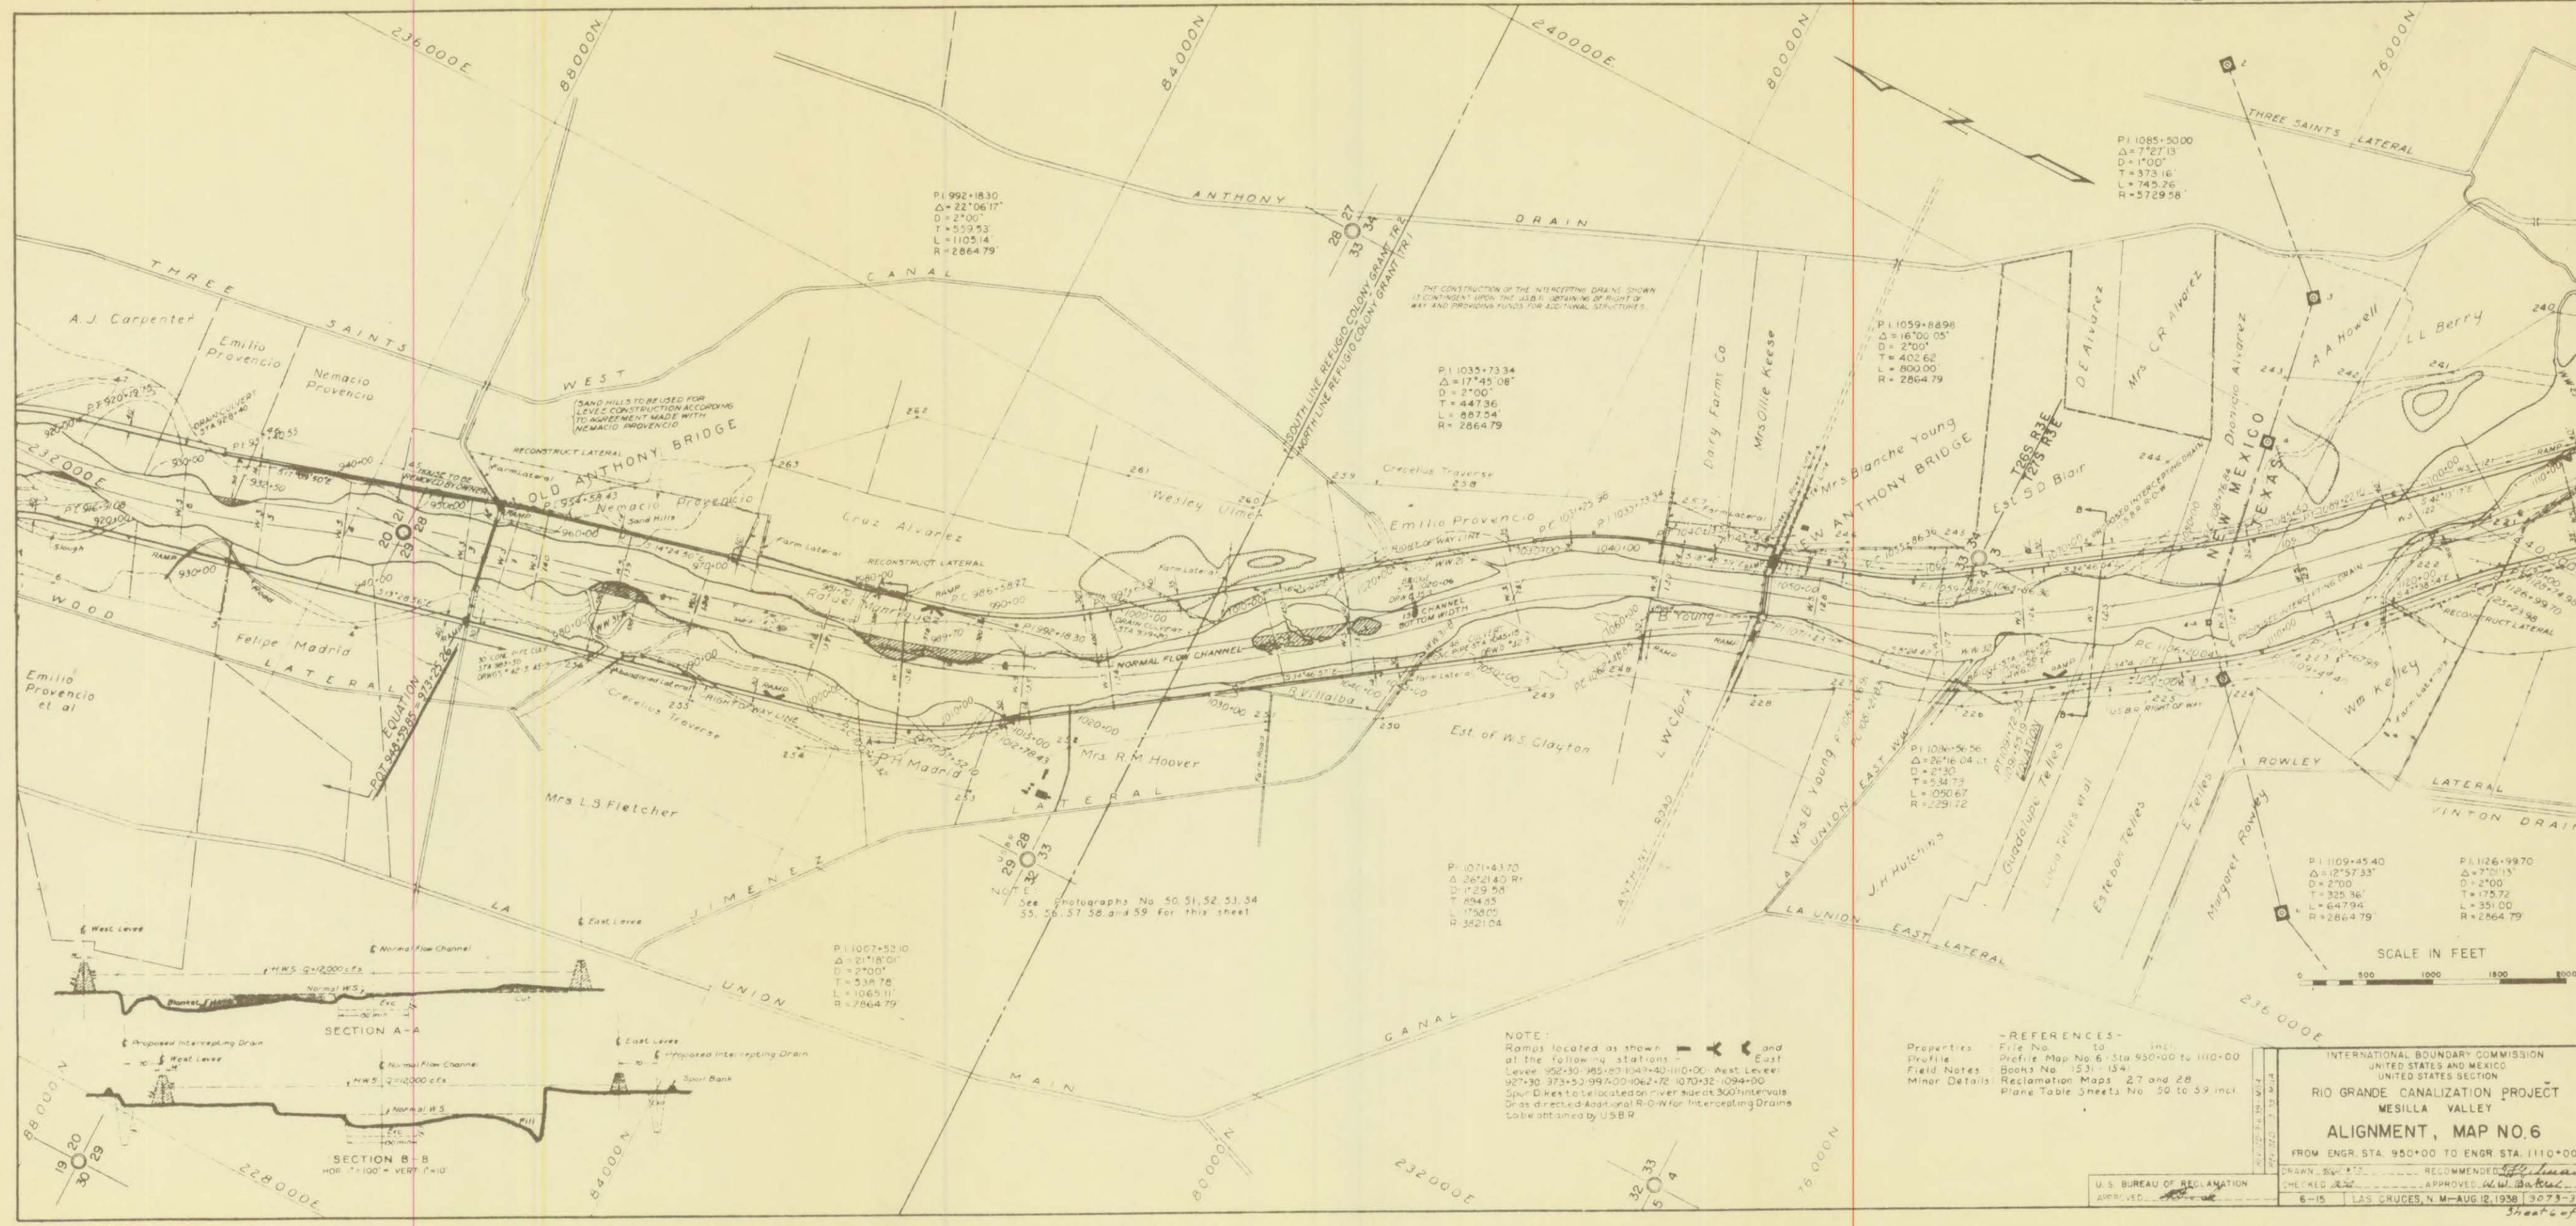

P1 992+18.30  
 $\Delta = 22^{\circ}06'17''$   
 $D = 2^{\circ}00'$   
 $T = 559.53$   
 $L = 1105.14$   
 $R = 2864.79$

P1 1035+73.34  
 $\Delta = 17^{\circ}45'08''$   
 $D = 2^{\circ}00'$   
 $T = 447.36$   
 $L = 887.34$   
 $R = 2864.79$

P1 1059+88.98  
 $\Delta = 16^{\circ}00'05''$   
 $D = 2^{\circ}00'$   
 $T = 402.62$   
 $L = 800.00$   
 $R = 2864.79$

P1 1085+90.00  
 $\Delta = 7^{\circ}27'13''$   
 $D = 1^{\circ}00'$   
 $T = 373.16$   
 $L = 745.26$   
 $R = 5729.58$

SAND HILLS TO BE USED FOR LEVEE CONSTRUCTION ACCORDING TO AGREEMENT MADE WITH NEMACIO PROVENCIO

THE CONSTRUCTION OF THE INTERCEPTING DRAINS SHOWN IS CONTINGENT UPON THE USBR OBTAINING OF RIGHT OF WAY AND PROVIDING FUNDS FOR ADDITIONAL STRUCTURES.

See Photographs No 50, 51, 52, 53, 54, 55, 56, 57, 58, and 59 for this sheet


P1 1007+52.10  
 $\Delta = 21^{\circ}18'01''$   
 $D = 2^{\circ}00'$   
 $T = 538.78$   
 $L = 1069.11$   
 $R = 2864.79$

P1 1071+43.70  
 $\Delta = 36^{\circ}21'40''$   
 $D = 2^{\circ}00'$   
 $T = 294.85$   
 $L = 1758.09$   
 $R = 3621.04$

P1 1034+54.56  
 $\Delta = 26^{\circ}16'04''$   
 $D = 2^{\circ}30'$   
 $T = 534.73$   
 $L = 1050.67$   
 $R = 2291.72$

P1 1109+45.40  
 $\Delta = 12^{\circ}57'33''$   
 $D = 2^{\circ}00'$   
 $T = 325.96$   
 $L = 647.94$   
 $R = 2864.79$

P1 1126+99.70  
 $\Delta = 7^{\circ}01'13''$   
 $D = 2^{\circ}00'$   
 $T = 175.72$   
 $L = 351.00$   
 $R = 2864.79$

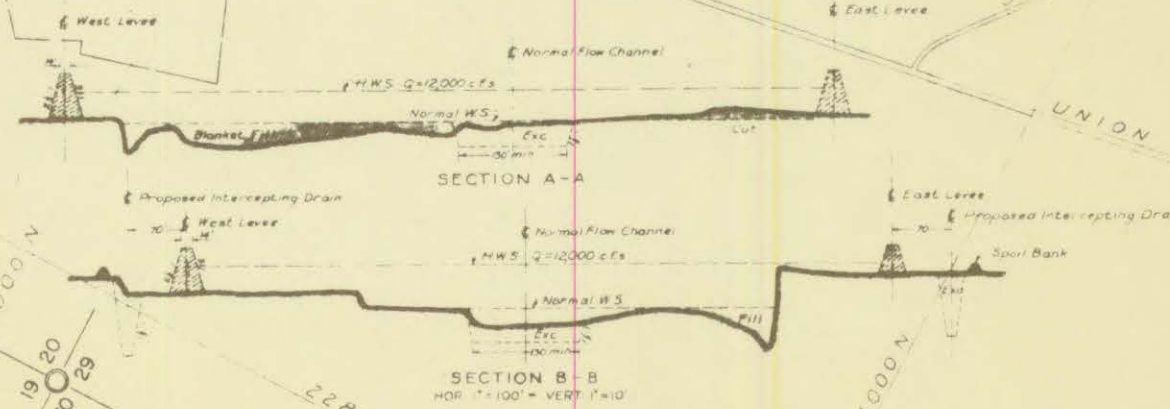


NOTE:  
 Ramps located as shown and at the following stations - East Levee 952+30, 965+80, 1049+40, 1110+00; West Levee 927+30, 973+50, 997+00, 1062+72, 1070+32, 1094+00  
 Spur Dikes to be located on river side at 300' intervals  
 Dike directed Additional R.O.W. for Intercepting Drains to be obtained by USBR

REFERENCES:  
 Properties - File No. 10, Inc.  
 Profile - Profile Map No. 6 - Sta 950+00 to 1110+00  
 Field Notes - Books No. 1531 - 1541  
 Minor Details - Reclamation Maps 27 and 28  
 Plane Table Sheets No. 50 to 59 incl

INTERNATIONAL BOUNDARY COMMISSION  
 UNITED STATES AND MEXICO  
 UNITED STATES SECTION  
**RIO GRANDE CANALIZATION PROJECT**  
 MESILLA VALLEY  
**ALIGNMENT, MAP NO. 6**  
 FROM ENGR. STA. 950+00 TO ENGR. STA. 1110+00

U.S. BUREAU OF RECLAMATION  
 DRAWN BY: [Signature] RECOMMENDED BY: [Signature]  
 CHECKED BY: [Signature] APPROVED BY: [Signature]  
 6-15 LAS CRUCES, N. M. - AUG 12, 1938 3073-38  
 Sheet 4 of 12

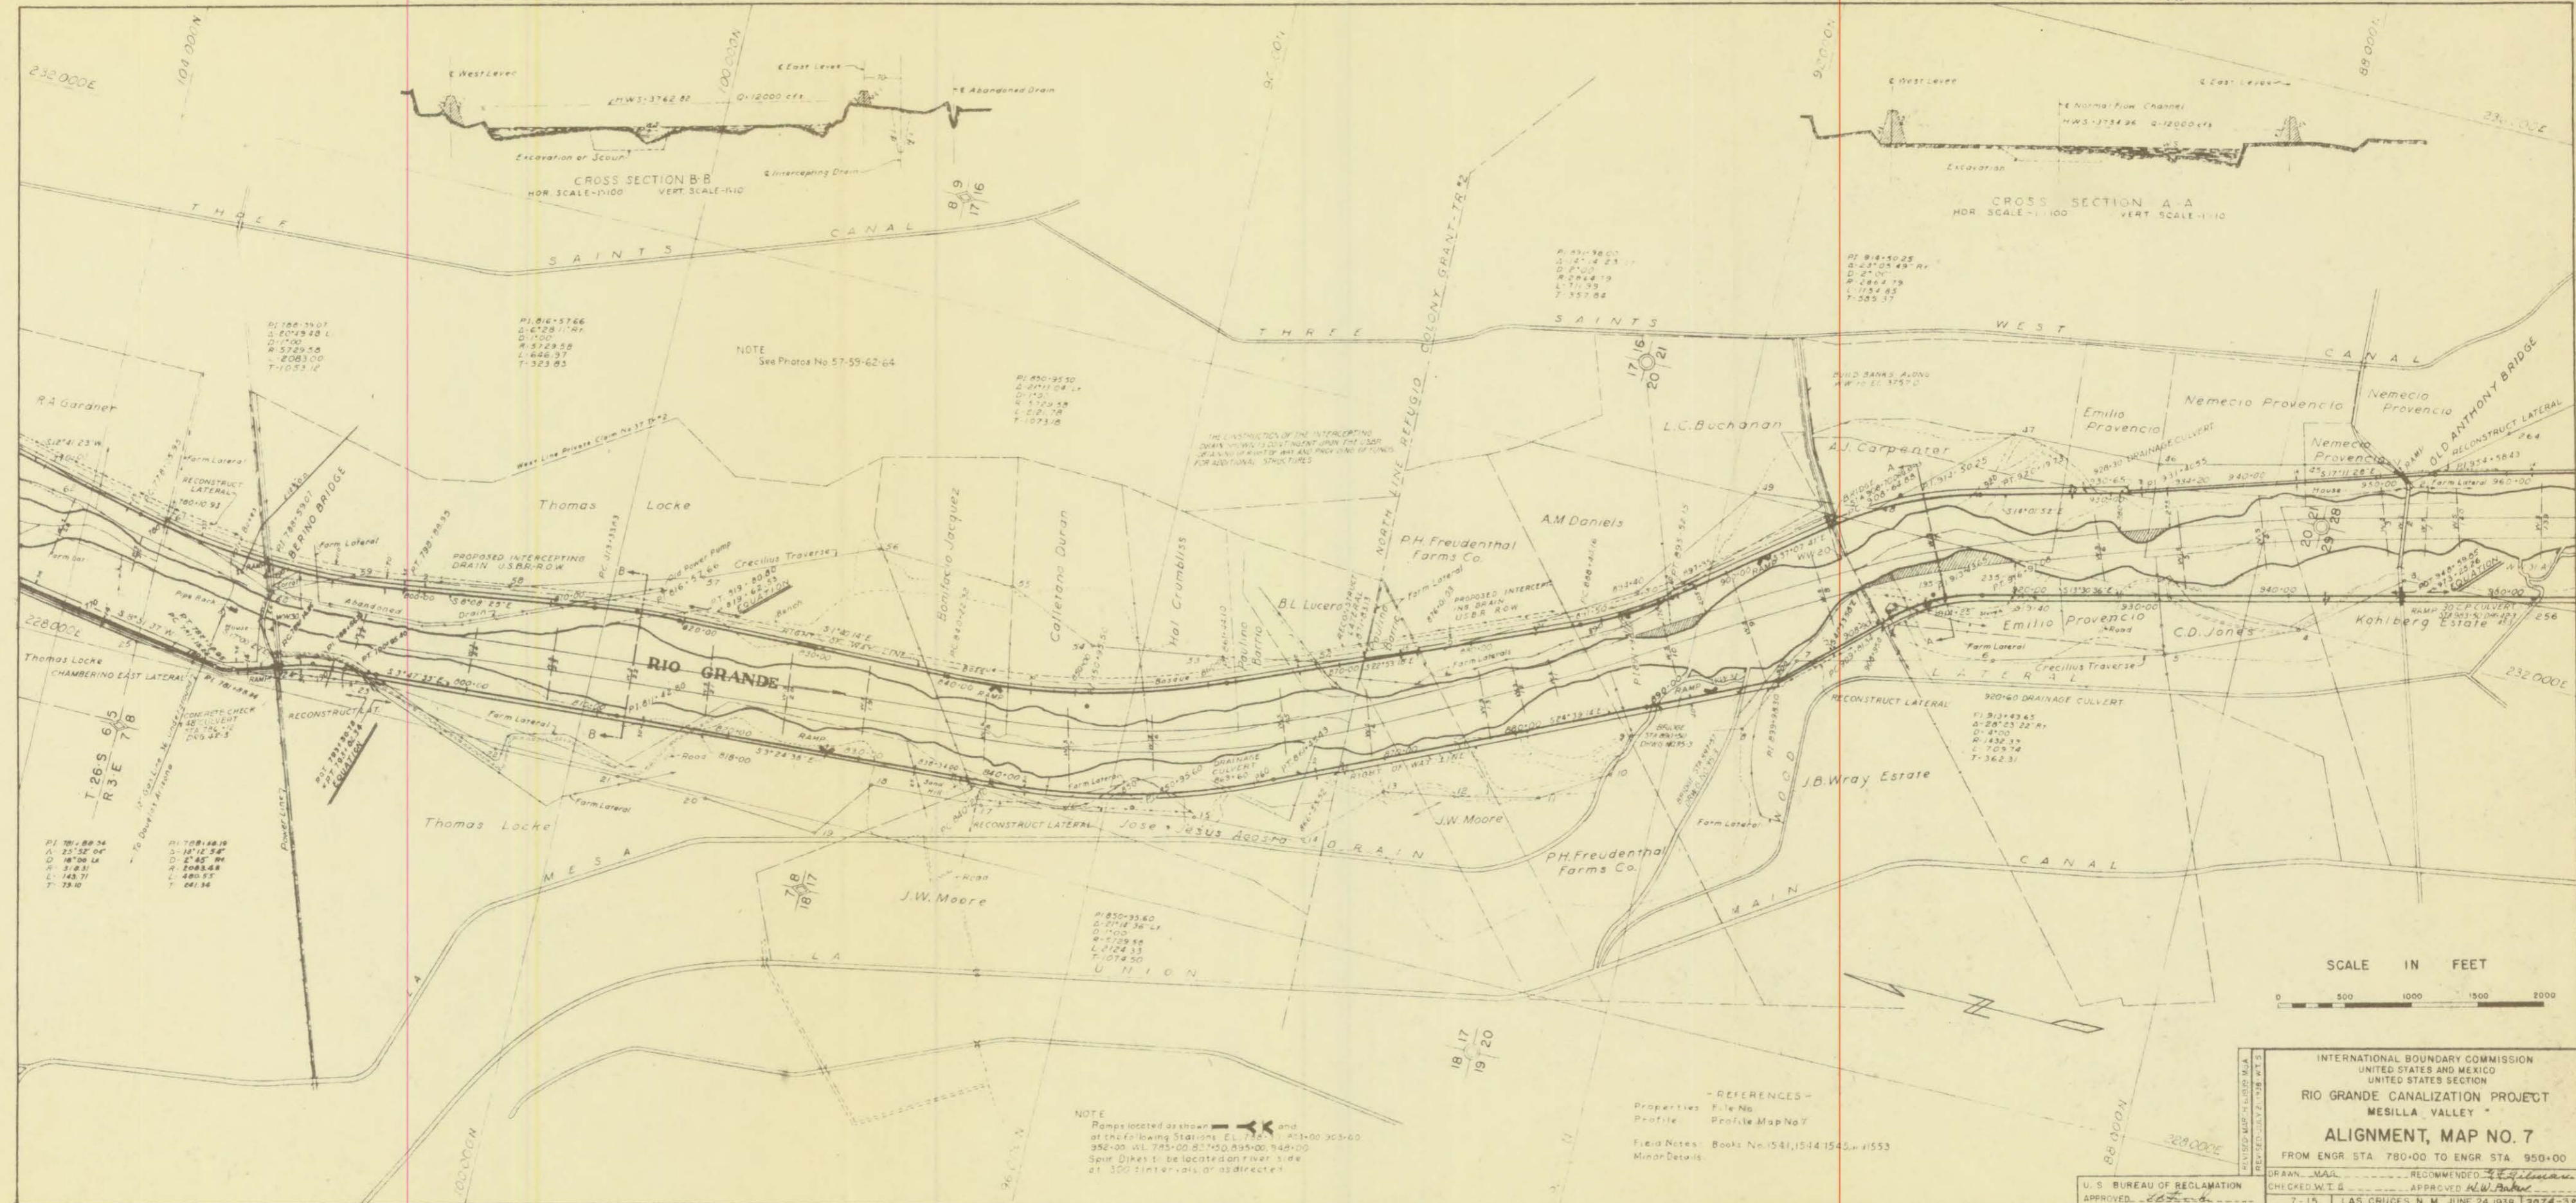

NOTE  
See Photos No. 57-59-62-64

THE CONSTRUCTION OF THE INTERCEPTING DRAIN AND WEIR IS CONTINGENT UPON THE USBR DETERMINING THE POINT OF WAY AND PROVISIONS OF FUNDS FOR ADDITIONAL STRUCTURES

NOTE  
Ramps located as shown and at the following Stations: EL. 735.00, 731.00, 703.00, 695.00, 685.00, 675.00, 5.00, 0.00  
Spur Dikes to be located on river side at 100' intervals, or as directed.


SCALE IN FEET



REFERENCES  
Properties File No.  
Profile Profile Map No. 7  
Field Notes Books No. 1541, 1544, 1545, 1553  
Minor Details

INTERNATIONAL BOUNDARY COMMISSION  
UNITED STATES AND MEXICO  
UNITED STATES SECTION  
RIO GRANDE CANALIZATION PROJECT  
MESILLA VALLEY  
ALIGNMENT, MAP NO. 7  
FROM ENGR STA. 780+00 TO ENGR STA. 950+00

U. S. BUREAU OF RECLAMATION  
APPROVED: 7-15 LAS CRUCES, N. M. JUNE 24, 1938 15074-37  
DRAWN: RECOMMENDED:   
CHECKED: APPROVED:

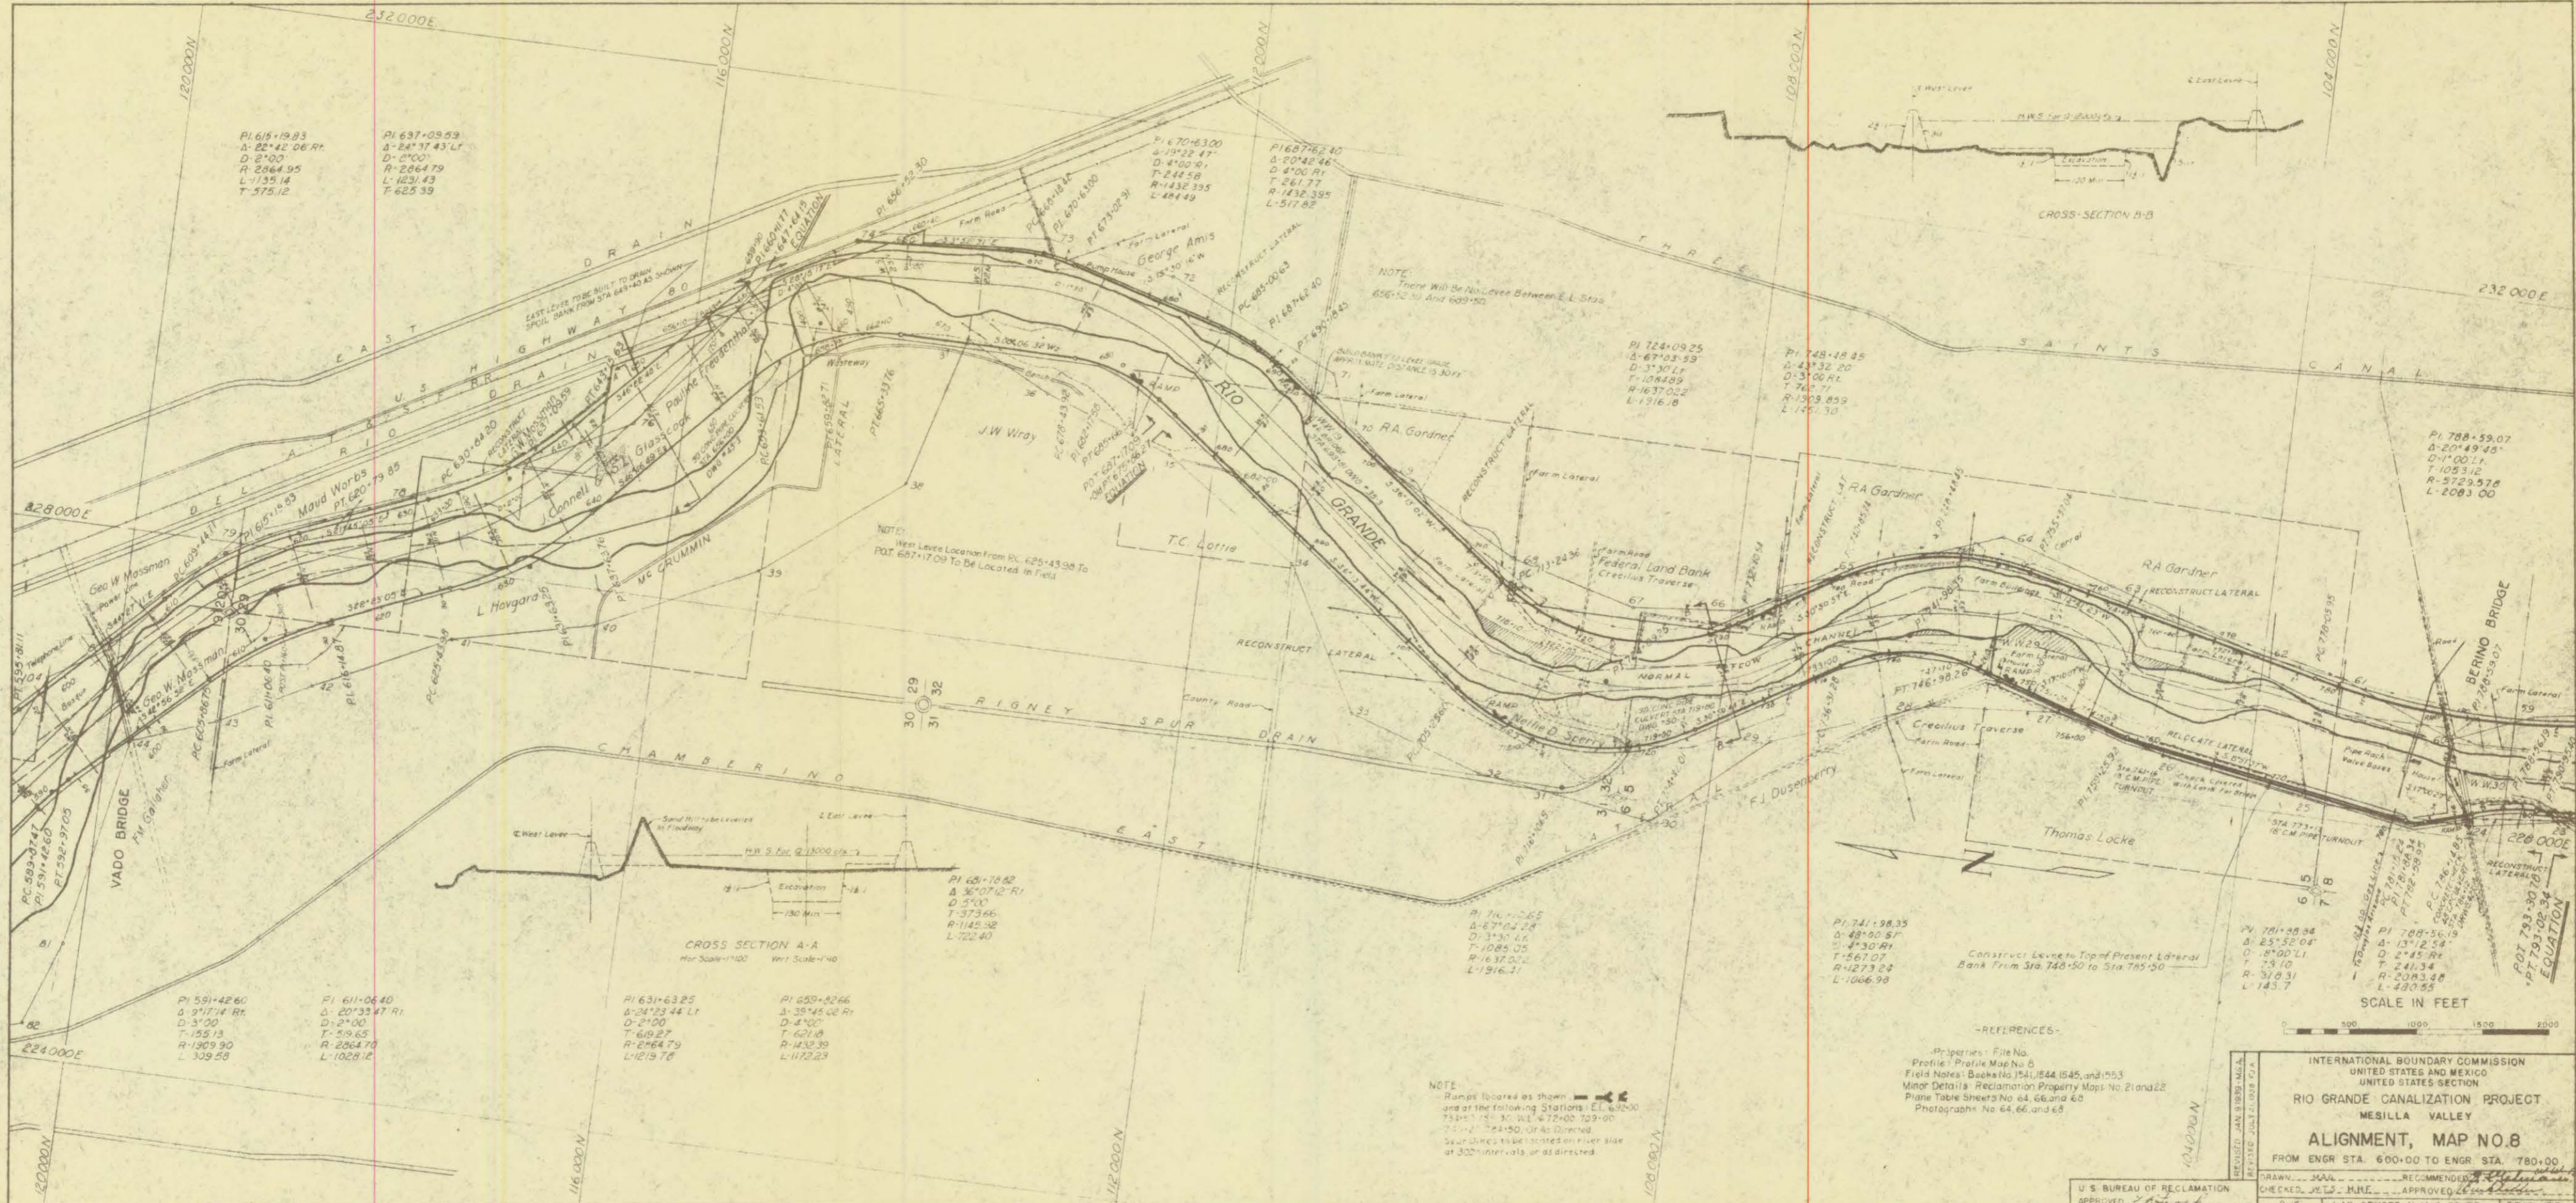

PI 615-19.83  
 Δ-22°42'06" Rt.  
 D-2°00'  
 R-2864.95  
 L-1135.14  
 T-515.12

PI 637-09.59  
 Δ-24°37'43" Lt.  
 D-2°00'  
 R-2864.79  
 L-1231.43  
 T-625.39

PI 670-63.00  
 Δ-17°22'47"  
 D-4°00' Lt.  
 T-244.58  
 R-1432.395  
 L-484.49

PI 687-62.40  
 Δ-20°42'46"  
 D-4°00' Rt.  
 T-261.77  
 R-1432.395  
 L-517.82

PI 724-09.25  
 Δ-67°03'59"  
 D-3°30' Lt.  
 T-1084.89  
 R-1637.022  
 L-1916.18

PI 748-48.85  
 Δ-4°32'20"  
 D-3°00' Rt.  
 T-768.71  
 R-1509.859  
 L-1457.30

PI 788-59.07  
 Δ-20°49'48"  
 D-1°00' Lt.  
 T-1053.12  
 R-5723.578  
 L-2083.00

NOTE:  
 West Levee Location from PC 625+43.38 To  
 POT 687+17.09 To Be Located in Field

NOTE:  
 There Will Be No Levee Between E.L. Stns  
 656+52.30 and 689+80



CROSS SECTION A-A  
 Hor Scale=1"=100' Vert Scale=1"=40'

PI 681-78.82  
 Δ-36°07'12" Rt.  
 D-5°00'  
 T-373.66  
 R-1145.32  
 L-722.40

PI 716-12.55  
 Δ-67°04'24"  
 D-3°30' Lt.  
 T-1085.05  
 R-1637.022  
 L-1916.18

PI 741-98.35  
 Δ-48°00'51"  
 D-4°30' Rt.  
 T-567.07  
 R-1273.24  
 L-1066.98

PI 781-88.58  
 Δ-25°52'04"  
 D-1°00' Lt.  
 T-73.10  
 R-318.31  
 L-145.7

PI 591-42.60  
 Δ-9°17'14" Rt.  
 D-3°00'  
 T-155.13  
 R-1909.90  
 L-309.58

PI 611-06.40  
 Δ-20°33'47" Rt.  
 D-2°00'  
 T-519.65  
 R-2864.70  
 L-1028.12

PI 631-63.25  
 Δ-24°23'44" Lt.  
 D-2°00'  
 T-619.27  
 R-2864.79  
 L-1219.78


PI 659-82.66  
 Δ-39°45'02" Rt.  
 D-4°00'  
 T-621.18  
 R-1432.39  
 L-1172.23

NOTE:  
 Ramps located as shown ———> and at the following Stations: EL 672-00 739-00 744-20 754-50, Or As Directed. Spur Dikes to be located on river side at 300' intervals, or as directed.

REFERENCES:  
 Properties: File No.  
 Profile: Profile Map No. 8  
 Field Notes: Books No. 1541, 1544, 1545, and 1553  
 Minor Details: Reclamation Property Maps No. 21 and 22  
 Plane Table Sheets No. 64, 66, and 68  
 Photographs No. 64, 66, and 68

INTERNATIONAL BOUNDARY COMMISSION  
 UNITED STATES AND MEXICO  
 UNITED STATES SECTION  
 RIO GRANDE CANALIZATION PROJECT  
 MESILLA VALLEY  
 ALIGNMENT, MAP NO. 8  
 FROM ENGR STA. 600+00 TO ENGR STA. 780+00

U.S. BUREAU OF RECLAMATION  
 DRAWN: JAVL  
 CHECKED: J.L.S. M.H.E.  
 RECOMMENDED: J.L.S. M.H.E.  
 APPROVED: J.L.S. M.H.E.  
 R-15 LAS CRUCES, N.M. 6-30-38 3D12-38

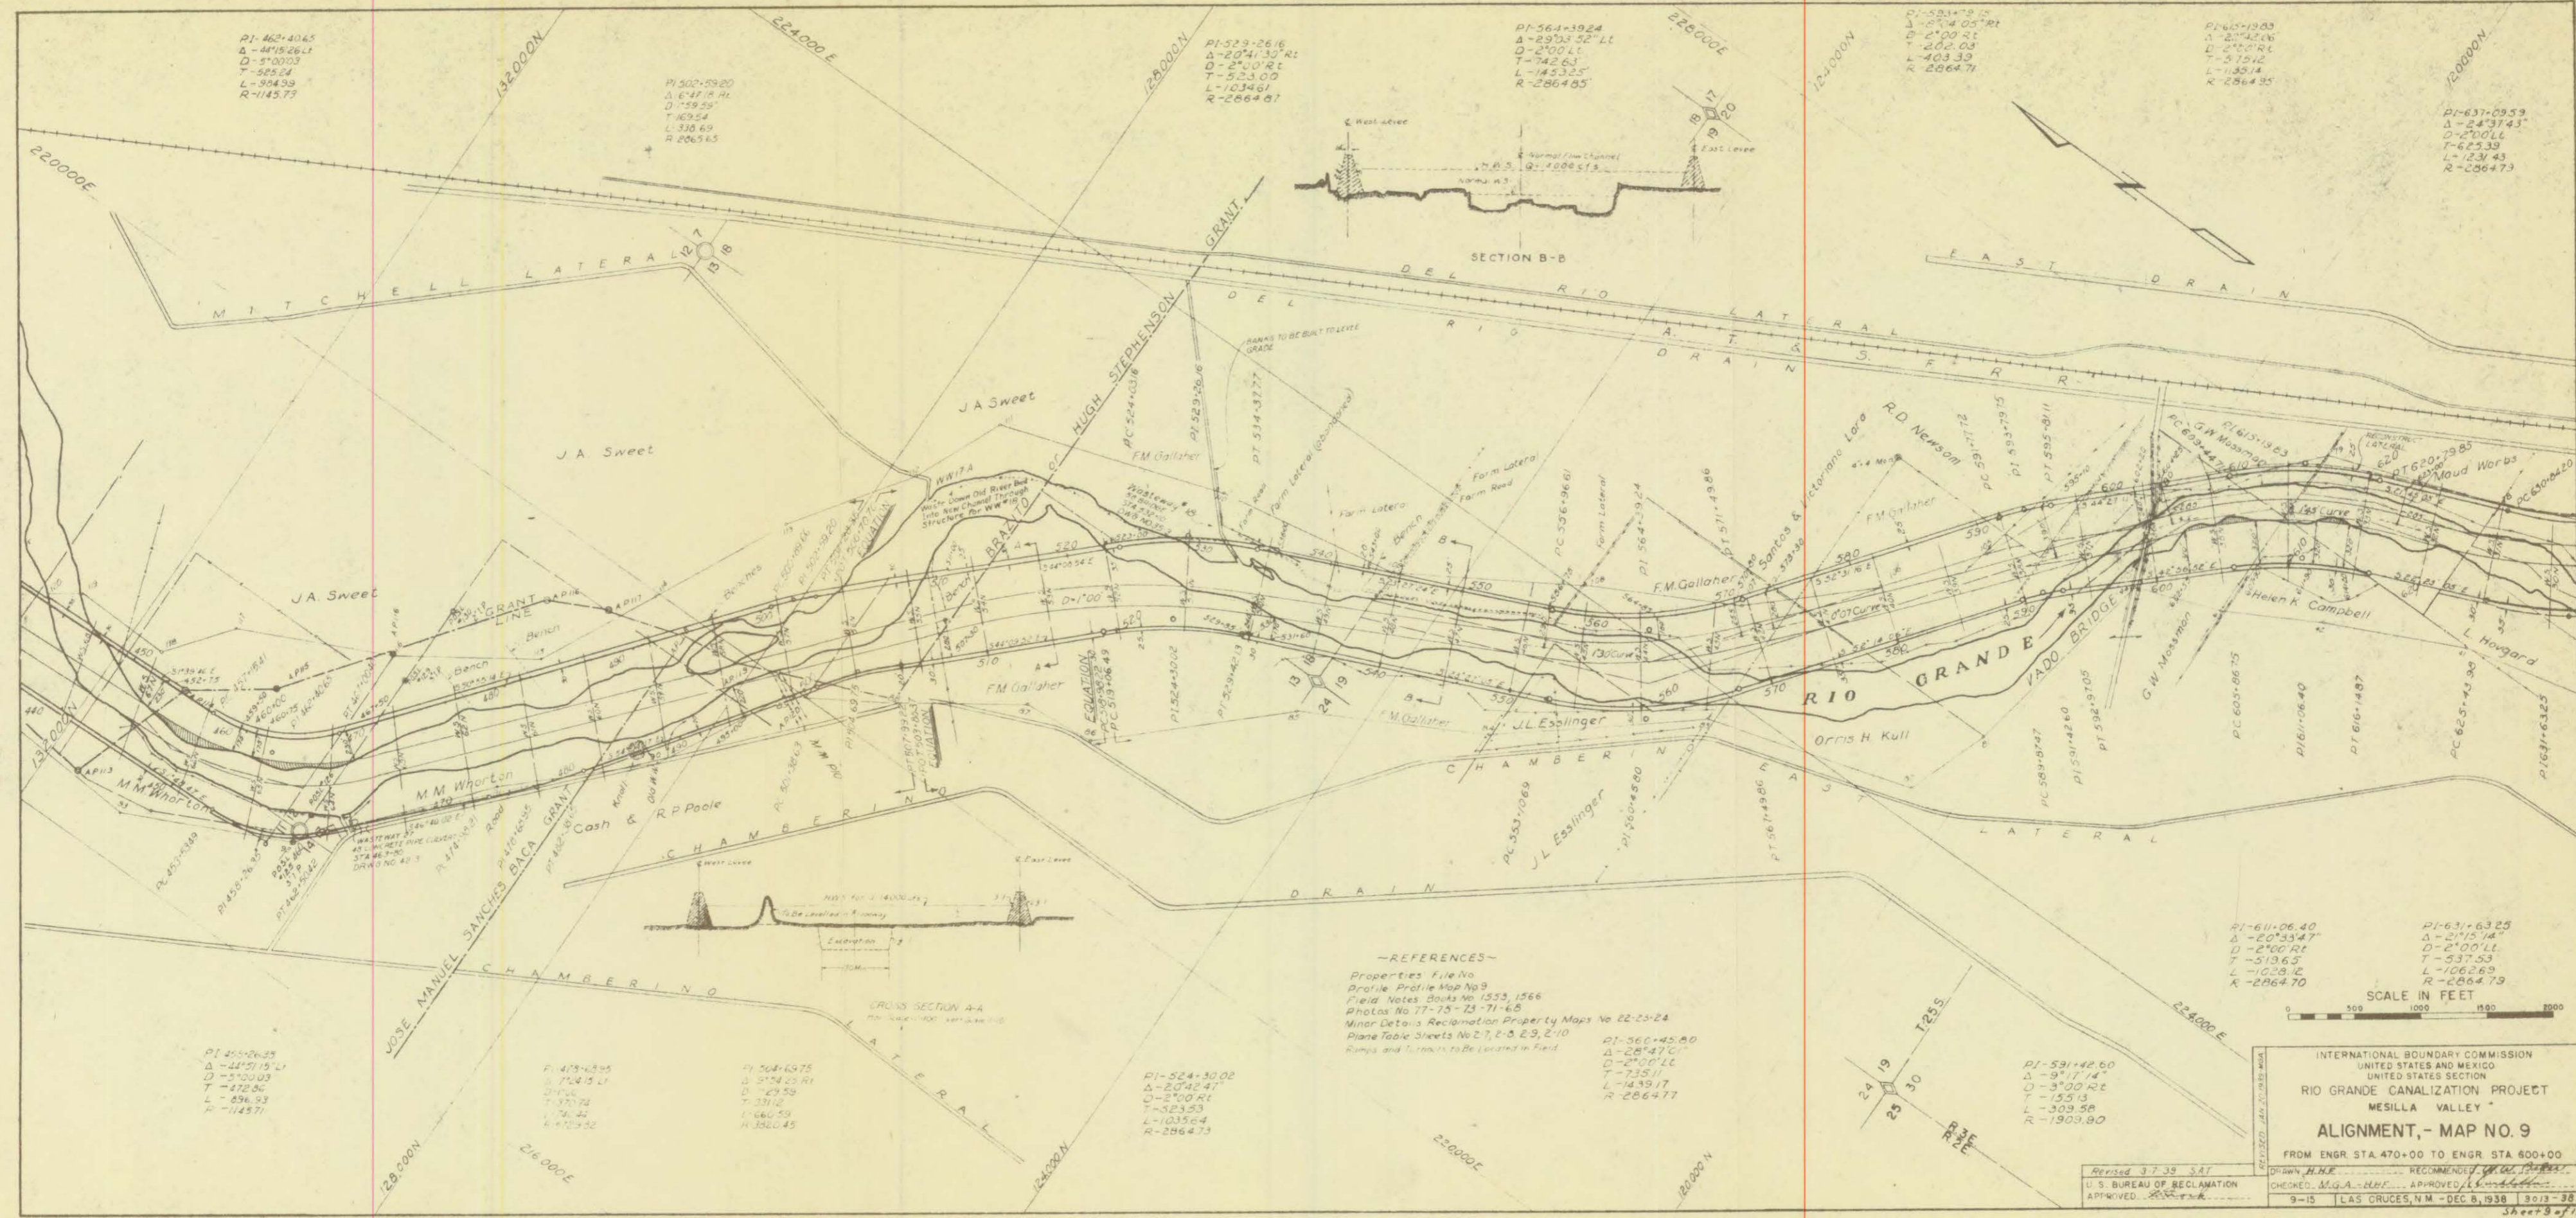

PI-462-4045  
 Δ-44°15'26" L  
 D-5°00'03"  
 T-525.24  
 L-904.99  
 R-1145.73

PI-502-5920  
 Δ-6°47'18" RL  
 D-1°59'55"  
 T-169.54  
 L-330.69  
 R-2065.65

PI-529-2616  
 Δ-20°41'30" RL  
 D-2°00'02"  
 T-523.00  
 L-1034.61  
 R-2864.87

PI-564-3924  
 Δ-29°03'52" LL  
 D-2°00'02"  
 T-742.63  
 L-1453.25  
 R-2864.85

PI-583-7915  
 Δ-2°04'05" RL  
 D-2°00'02"  
 T-202.03  
 L-403.39  
 R-2864.71

PI-605-1983  
 Δ-2°04'26"  
 D-2°00'02"  
 T-202.03  
 L-403.39  
 R-2864.71

PI-637-0959  
 Δ-24°37'43"  
 D-2°00'02"  
 T-625.39  
 L-1231.43  
 R-2864.73

PI-455-2623  
 Δ-44°51'15" L  
 D-5°00'03"  
 T-472.86  
 L-896.93  
 R-1145.71

PI-473-6935  
 Δ-7°24'13" L  
 D-1°00'00"  
 T-370.74  
 L-740.44  
 R-1145.71

PI-508-1975  
 Δ-5°24'25" RL  
 D-1°00'00"  
 T-331.12  
 L-660.59  
 R-1320.45

PI-524-3002  
 Δ-20°42'47"  
 D-2°00'02"  
 T-523.53  
 L-1035.64  
 R-2864.73

PI-560-4580  
 Δ-28°47'01"  
 D-2°00'02"  
 T-725.11  
 L-1439.17  
 R-2864.77


PI-591-4260  
 Δ-9°17'14"  
 D-3°00'02"  
 T-155.13  
 L-309.58  
 R-1903.80

PI-611-0640  
 Δ-2°15'14"  
 D-2°00'02"  
 T-513.65  
 L-1028.12  
 R-2864.70

PI-631-6325  
 Δ-2°15'14"  
 D-2°00'02"  
 T-513.65  
 L-1028.12  
 R-2864.70

**REFERENCES**

- Properties File No.
- Profile Profile Map No. 9
- Field Notes Books No. 1553, 1566
- Photos No. 77-75-73-71-68
- Minor Details Reclamation Property Maps No. 22-23-24
- Plane Table Sheets No. 2, 7, 2-5, 2-9, 2-10
- Ramps and Turnouts to Be Located in Field


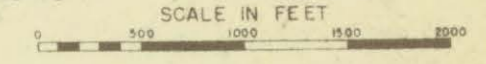


INTERNATIONAL BOUNDARY COMMISSION  
 UNITED STATES AND MEXICO  
 UNITED STATES SECTION  
**RIO GRANDE CANALIZATION PROJECT**  
 MESILLA VALLEY  
**ALIGNMENT, - MAP NO. 9**

FROM ENGR. STA. 470+00 TO ENGR. STA. 600+00

Revised 3-7-39 S.A.T.  
 U.S. BUREAU OF RECLAMATION  
 APPROVED: [Signature]

CHECKED: M.G.A.-H.M.F. APPROVED: [Signature]  
 9-15 LAS CRUCES, N.M. - DEC. 8, 1938 3013-38  
 Sheet 9 of 12

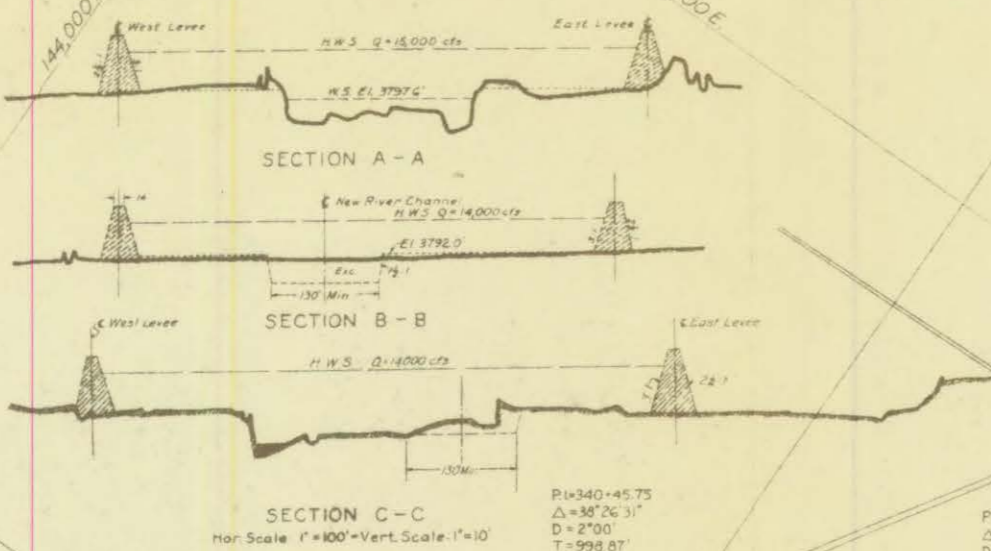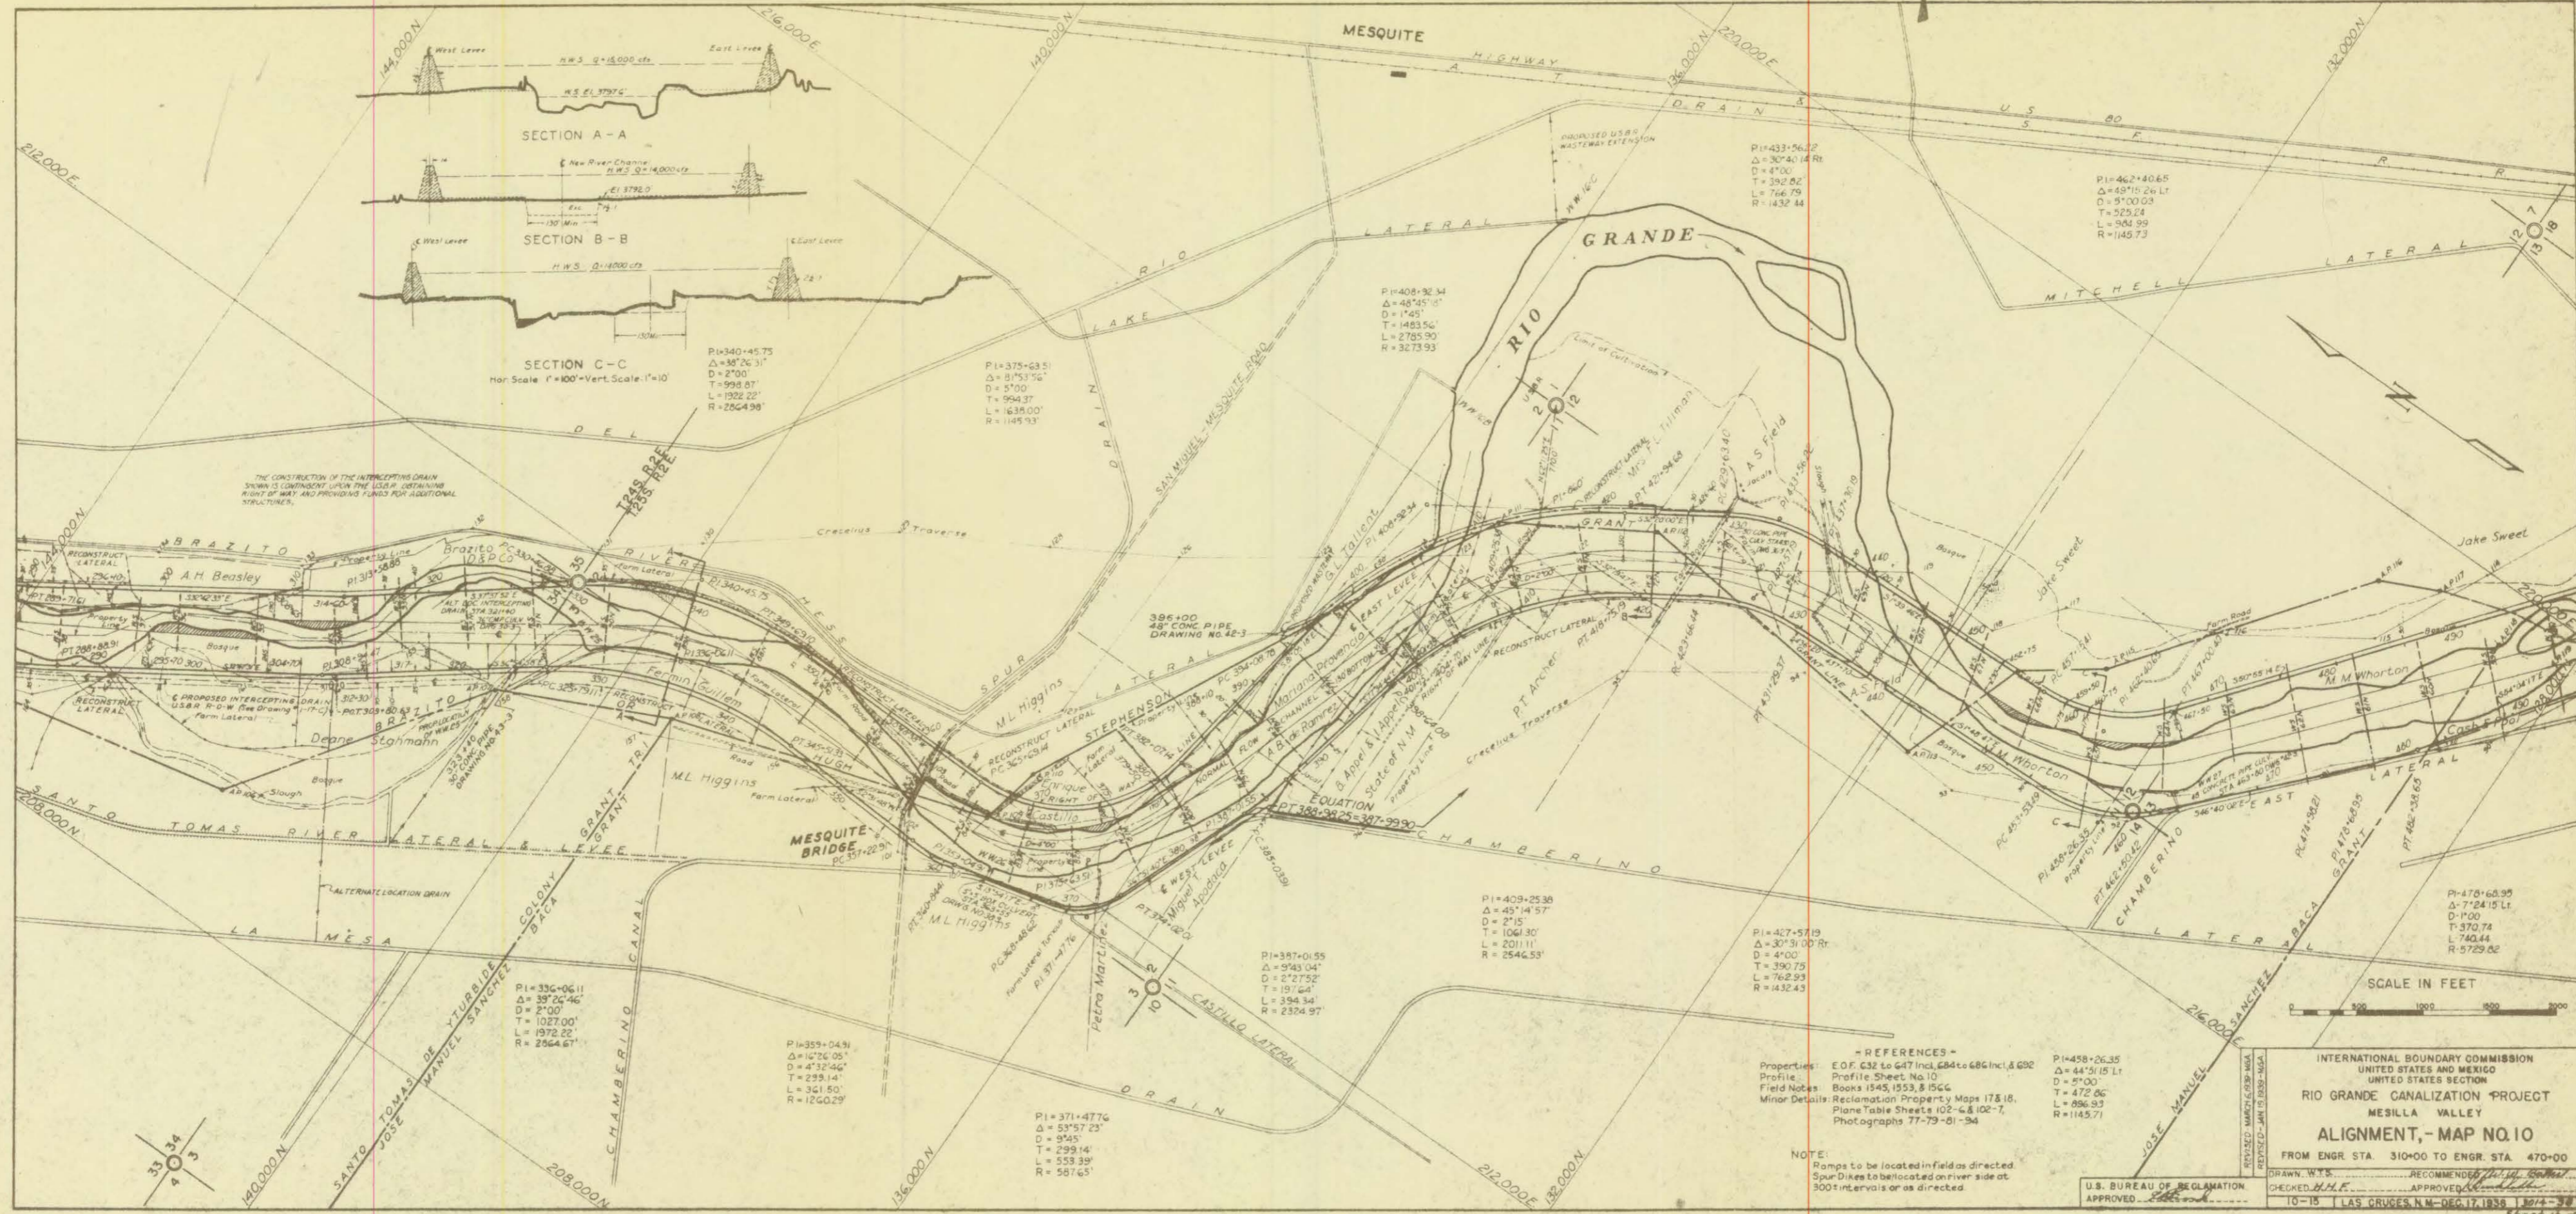

THE CONSTRUCTION OF THE INTERCEPTING DRAIN SHOWN IS CONTINGENT UPON THE USBR OBTAINING RIGHT OF WAY AND PROVIDING FUNDS FOR ADDITIONAL STRUCTURES.



- REFERENCES**
- Properties: E.O.F. 632 to 647 Incl, 684 to 686 Incl, & 692
  - Profile: Profile Sheet No. 10
  - Field Notes: Books 1545, 1553, & 1566
  - Minor Details: Reclamation Property Maps 178, 18, Plane Table Sheets 102-6 & 102-7, Photographs 77-79-81-94

**NOTE:**  
Ramps to be located in field as directed.  
Spur Dikes to be located on river side at 300' intervals or as directed.

U.S. BUREAU OF RECLAMATION  
APPROVED \_\_\_\_\_

INTERNATIONAL BOUNDARY COMMISSION  
UNITED STATES AND MEXICO  
UNITED STATES SECTION  
**RIO GRANDE CANALIZATION PROJECT**  
MESILLA VALLEY  
**ALIGNMENT, - MAP NO. 10**  
FROM ENGR. STA. 310+00 TO ENGR. STA. 470+00

DRAWN: W.T.S. RECOMMENDED: J.H. ...  
CHECKED: H.H.E. APPROVED: ...  
10-15 LAS CRUCES, N.M. - DEC. 17, 1938

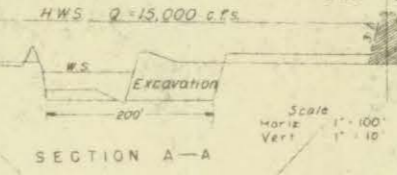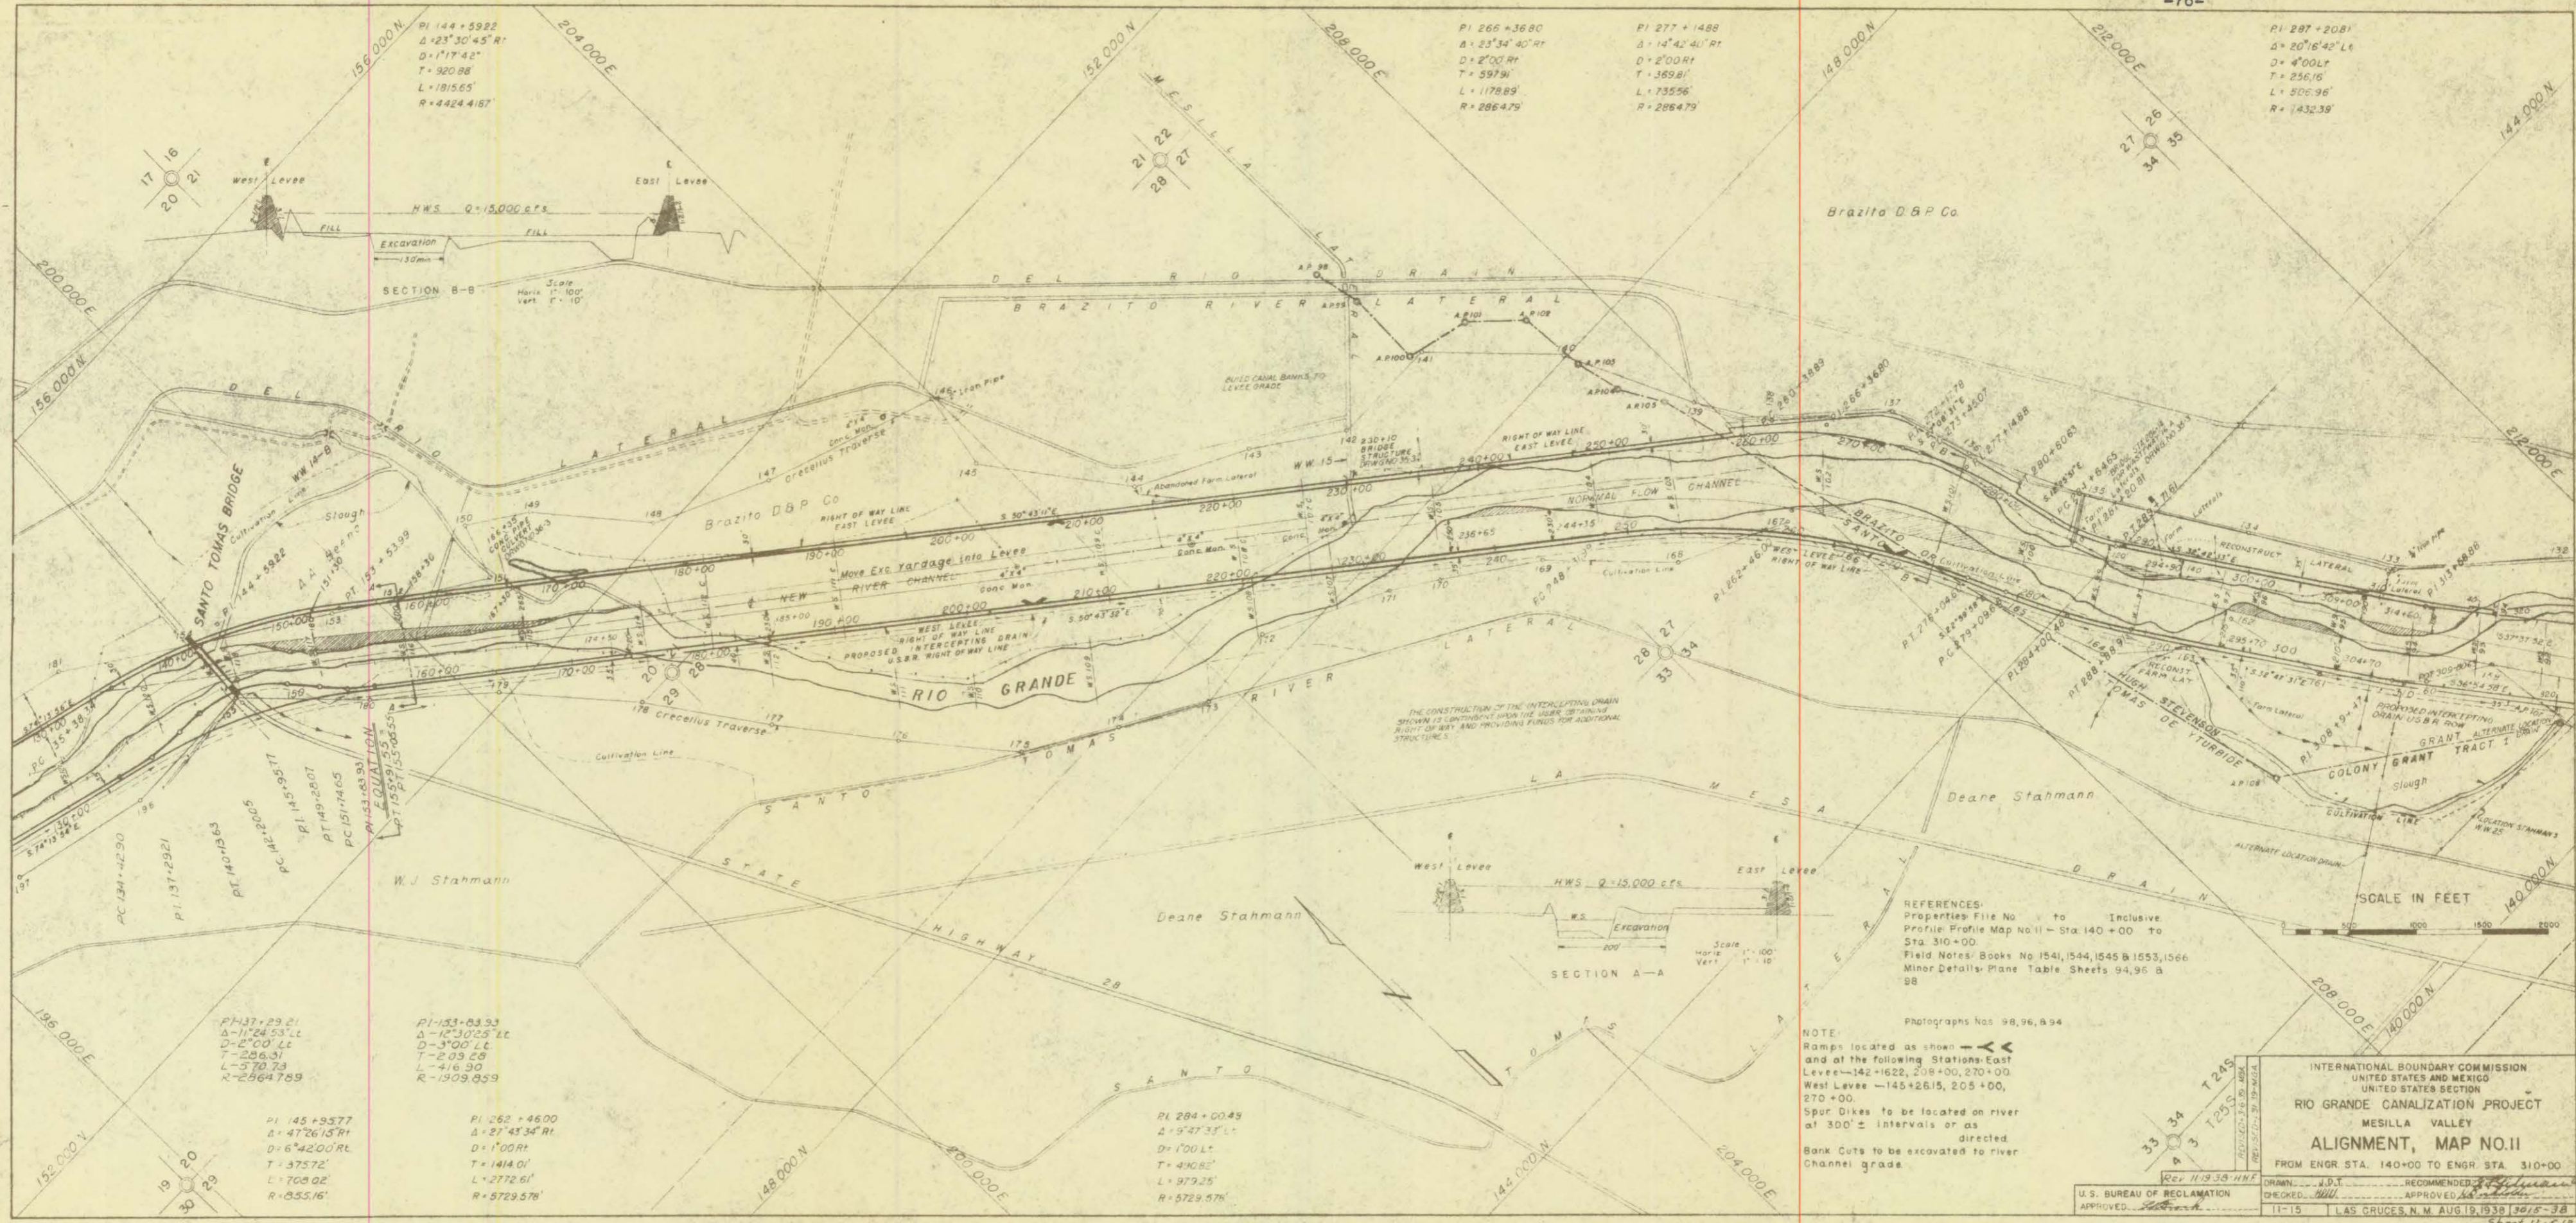


REFERENCES:  
 Properties: File No. to Inclusive  
 Profile Profile Map No. 11 - Sta. 140+00 to Sta. 310+00  
 Field Notes: Books No. 1541, 1544, 1545 & 1553, 1566  
 Minor Details: Plane Table Sheets 94, 95 & 98

NOTE:  
 Ramps located as shown → ←  
 and at the following Stations: East Levee - 142+16.22, 208+00, 270+00  
 West Levee - 145+26.15, 205+00, 270+00  
 Spur Dikes to be located on river at 300' ± intervals or as directed  
 Bank Cuts to be excavated to river Channel grade.

INTERNATIONAL BOUNDARY COMMISSION  
 UNITED STATES AND MEXICO  
 UNITED STATES SECTION  
**RIO GRANDE CANALIZATION PROJECT**  
 MESILLA VALLEY  
**ALIGNMENT, MAP NO. 11**  
 FROM ENGR. STA. 140+00 TO ENGR. STA. 310+00


U.S. BUREAU OF RECLAMATION  
 DRAWN: J.P.T. RECOMMENDED: [Signature]  
 CHECKED: [Signature] APPROVED: [Signature]  
 11-15 LAS CRUCES, N. M. AUG. 19, 1938 3015-38  
 Sheet 11 of 12



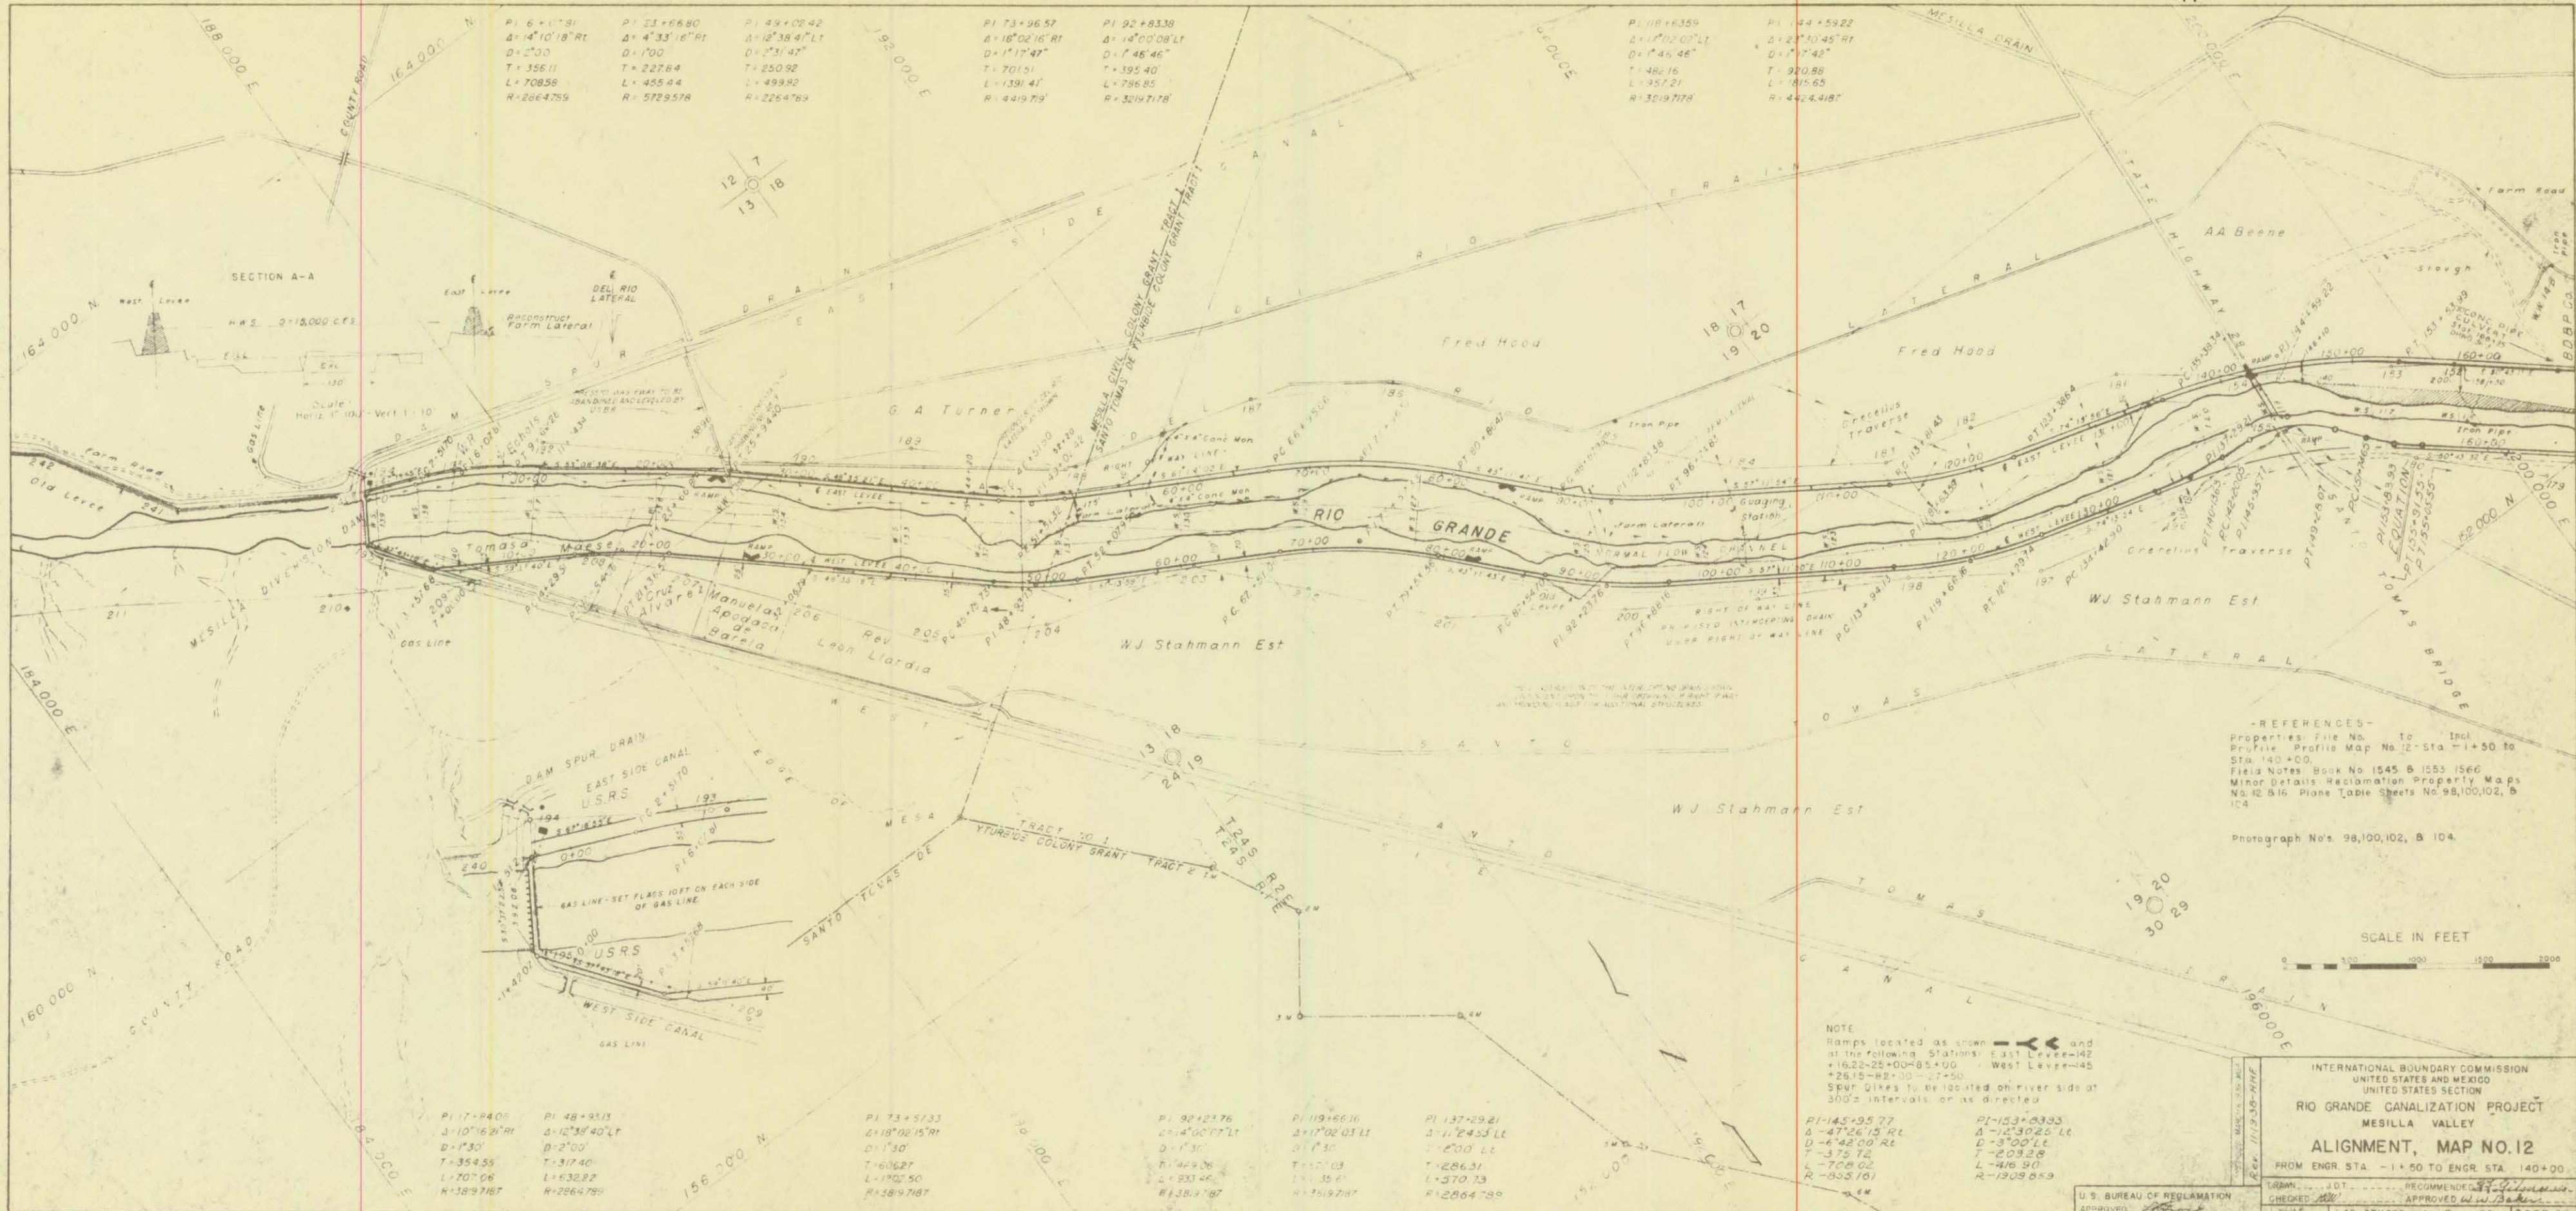

PI 6+07.81 Δ=14°10'18" Rt D=2°30' T=355.11 L=708.58 R=2864.759	PI 23+66.80 Δ=4°33'16" Rt D=1°00' T=227.64 L=455.44 R=5729.578	PI 49+02.42 Δ=12°38'41" Lt D=2°31'47" T=250.92 L=499.92 R=2264.769	PI 73+96.57 Δ=16°02'16" Rt D=1°17'47" T=701.51 L=1391.41 R=4419.719	PI 92+83.38 Δ=14°00'09" Lt D=1°45'46" T=395.40 L=796.85 R=3219.718	PI 118+63.59 Δ=17°02'02" Lt D=1°45'46" T=482.16 L=957.21 R=3219.718	PI 144+59.22 Δ=2°10'45" Rt D=1°17'42" T=920.88 L=1815.65 R=4424.3187
---	---	---	--	---	--	---

SECTION A-A

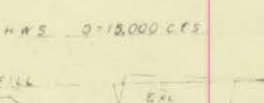

- REFERENCES -  
 Properties File No. to Incl  
 Profile Profile Map No 12 - Sta - 1+50 to  
 Sta 140+00  
 Field Notes Book No 1545 B 1553 1566  
 Minor Details Reclamation Property Maps  
 No 12 B16 Plane Table Sheets No 98,100,102, B  
 104

Photograph No's. 98,100,102, B 104.

SCALE IN FEET

INTERNATIONAL BOUNDARY COMMISSION  
 UNITED STATES AND MEXICO  
 UNITED STATES SECTION  
**RIO GRANDE CANALIZATION PROJECT**  
 MESILLA VALLEY  
**ALIGNMENT, MAP NO. 12**  
 FROM ENGR. STA. 1+50 TO ENGR. STA. 140+00

NOTE  
 Ramps located as shown and  
 at the following Stations: East Lateral-142  
 +16.22-25+00-85+00 West Lateral-145  
 +26.15-82+00-27+50  
 Spur Dikes to be located on river side at  
 300' intervals, or as directed

PI 17+24.09 Δ=10°16'21" Rt D=1°30' T=354.55 L=707.06 R=2864.759	PI 48+93.13 Δ=12°38'40" Lt D=2°00' T=317.40 L=632.22 R=2864.759
--	--

PI 73+57.33 Δ=18°02'15" Rt D=1°30' T=606.27 L=1202.50 R=3819.7187
--

PI 92+23.76 Δ=14°00'09" Lt D=1°30' T=449.06 L=898.16 R=3219.7187
---

PI 118+66.16 Δ=17°02'02" Lt D=1°30' T=482.16 L=957.21 R=3219.7187
--


PI 137+29.21 Δ=11°24'55" Lt D=1°20'00" Lt T=286.31 L=570.73 R=2864.759
---

PI 145+25.77 Δ=47°26'15" Rt D=6°42'00" Rt T=375.72 L=708.02 R=835.101
--

PI 153+83.33 Δ=12°30'25" Lt D=3°00'00" Lt T=203.28 L=416.90 R=1309.859
---

U.S. BUREAU OF RECLAMATION  
 APPROVED: [Signature]

RECOMMENDED: [Signature]  
 CHECKED: [Signature] APPROVED: [Signature]  
 LAS CRUCES, N.M. 7-1-38 3075-38

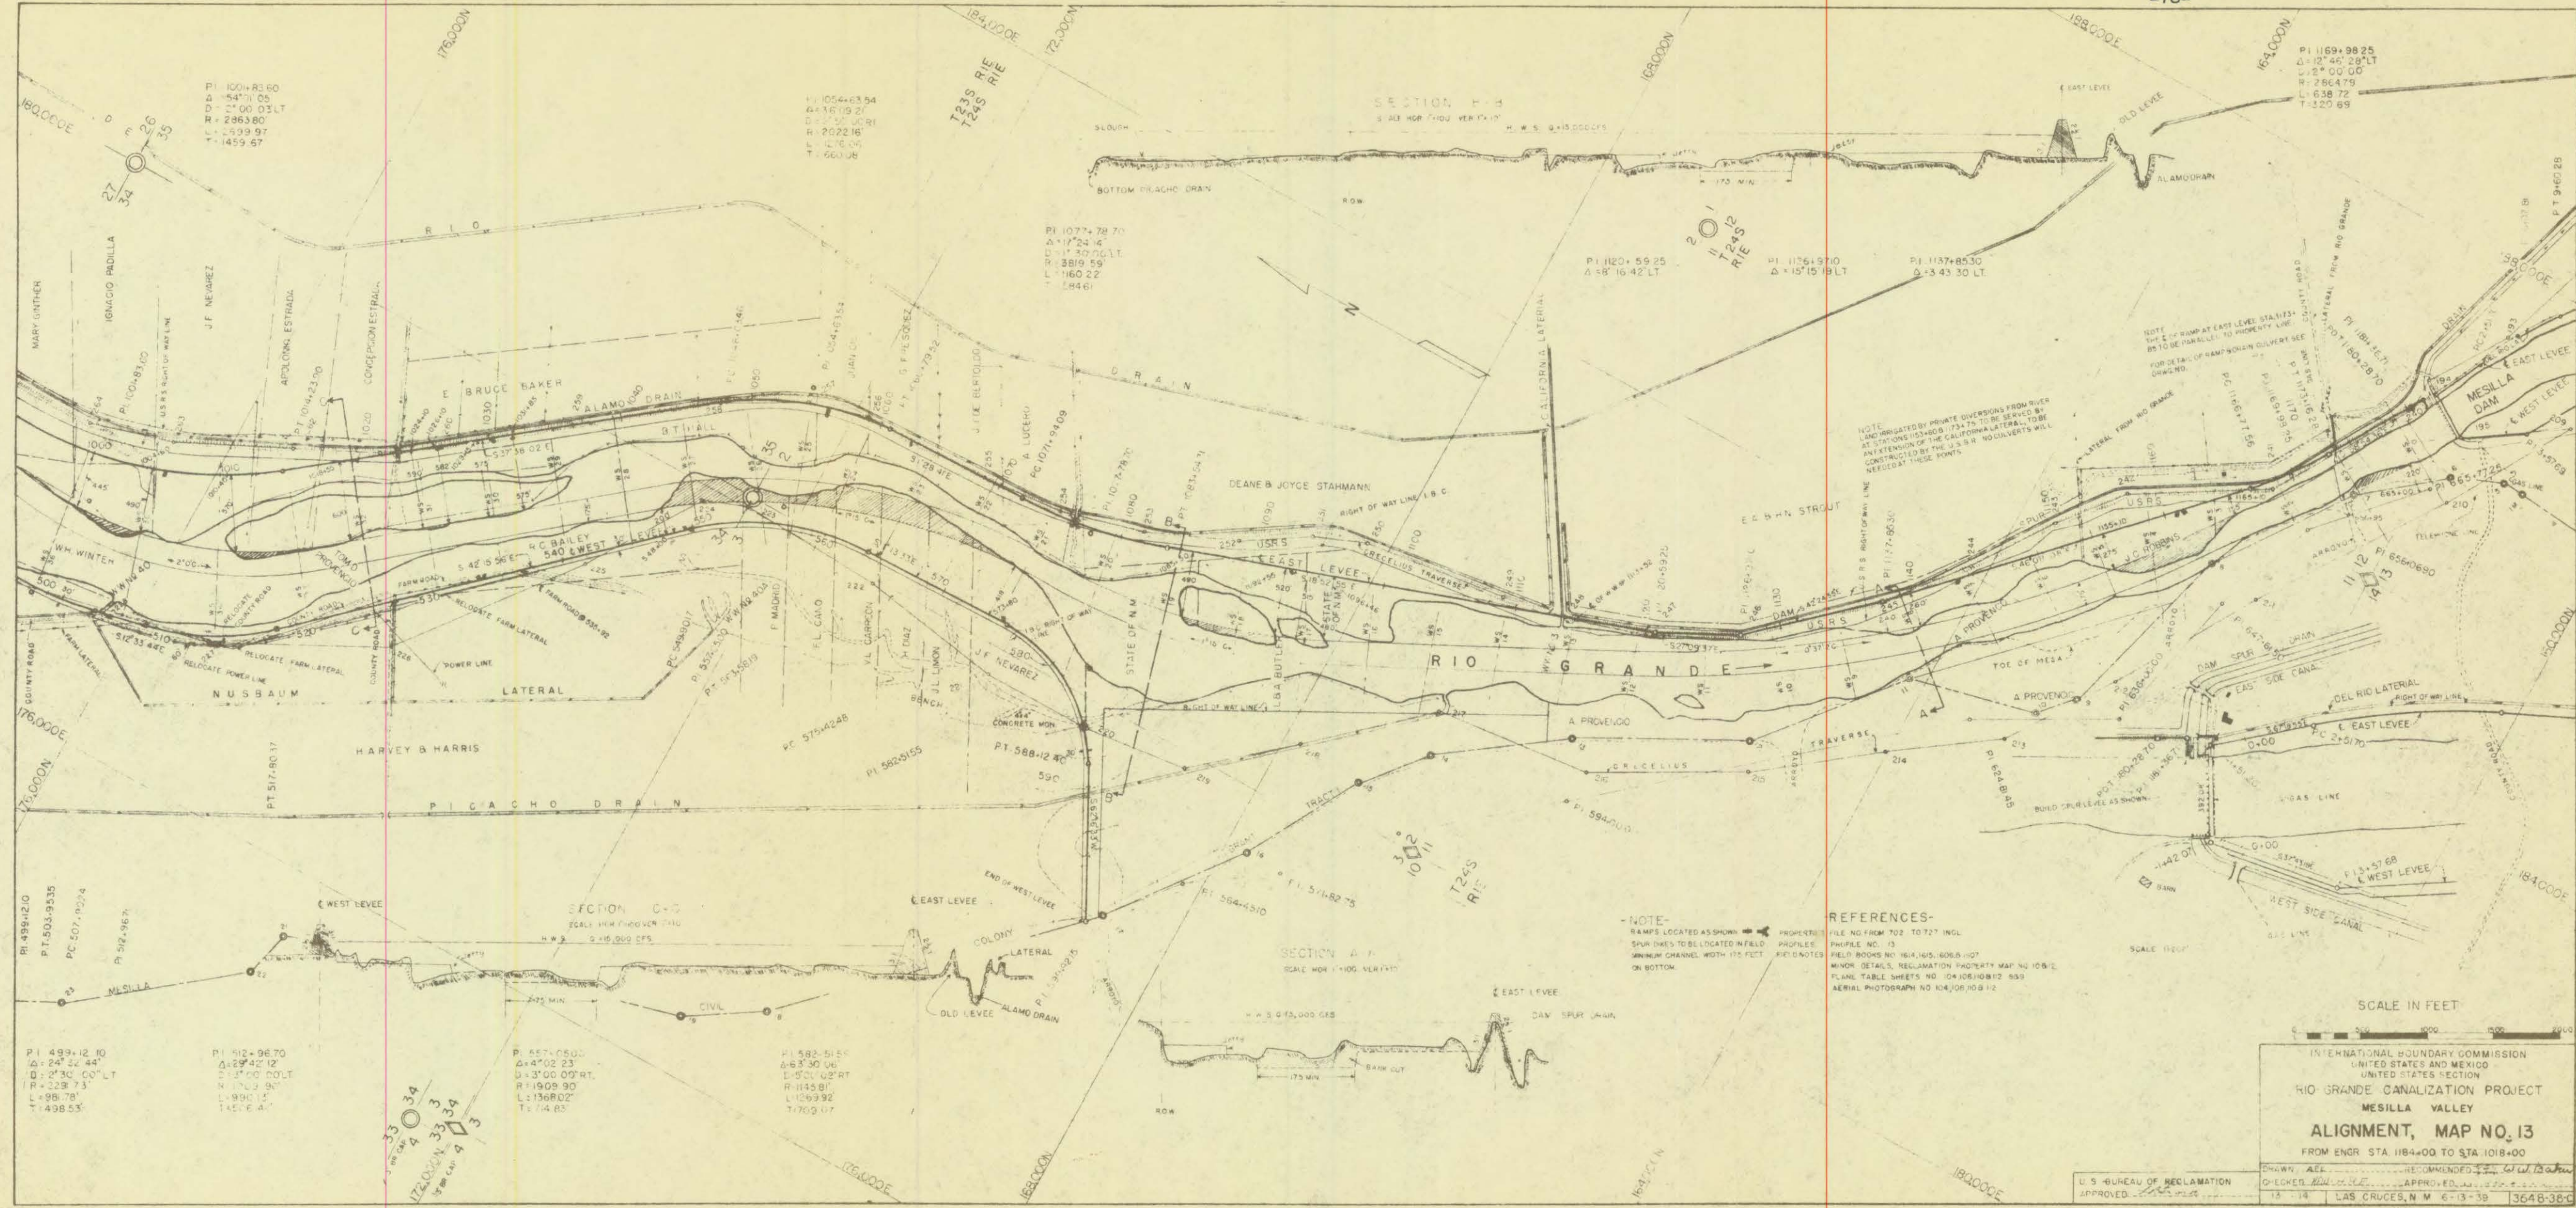

PI 100+83.60  
Δ=12°46'28"LT  
D=12°00'00"LT  
R=2863.80  
L=2599.97  
T=1459.67

PI 105+63.94  
Δ=16°19'21"  
D=12°00'00"LT  
R=2863.80  
L=2599.97  
T=1459.67

PI 107+78.70  
Δ=17°24'16"  
D=12°00'00"LT  
R=2863.80  
L=2599.97  
T=1459.67

PI 1120+59.25  
Δ=8°16'42"LT

PI 1126+97.10  
Δ=15°15'19"LT

PI 1137+85.30  
Δ=13°43'30"LT

PI 1169+98.25  
Δ=12°46'28"LT  
D=12°00'00"LT  
R=2863.80  
L=2599.97  
T=1459.67

PI 499+12.10  
Δ=24°24'44"  
D=12°00'00"LT  
R=2863.80  
L=2599.97  
T=1459.67

PI 512+96.70  
Δ=29°42'12"  
D=12°00'00"LT  
R=2863.80  
L=2599.97  
T=1459.67

PI 557+05.00  
Δ=4°02'23"  
D=12°00'00"LT  
R=2863.80  
L=2599.97  
T=1459.67

PI 582+51.55  
Δ=6°33'30"UB  
D=12°00'00"LT  
R=2863.80  
L=2599.97  
T=1459.67

33  
34  
33  
34  
33  
34  
33  
34

**NOTE-**  
RAMP LOCATED AS SHOWN  
SPUR DAMS TO BE LOCATED IN FIELD  
MINIMUM CHANNEL WIDTH 175 FEET  
ON BOTTOM


**REFERENCES-**  
FILE NO FROM 702 TO 727 INCL  
PHURLE NO. 13  
FIELD BOOKS NO. 161, 165, 168, 167  
MINOR DETAILS REGULATION PROPERTY MAP NO. 106 & 2  
PLANE TABLE SHEETS NO. 104, 105, 108, 112, 433  
AERIAL PHOTOGRAPH NO. 104, 109, 108, 112

SCALE 1"=100'


SCALE IN FEET

INTERNATIONAL BOUNDARY COMMISSION  
UNITED STATES AND MEXICO  
UNITED STATES SECTION  
**RIO GRANDE CANALIZATION PROJECT**  
MESILLA VALLEY  
**ALIGNMENT, MAP NO. 13**  
FROM ENGR STA 1184+00 TO STA 1018+00

U.S. BUREAU OF RECLAMATION  
APPROVED: [Signature]

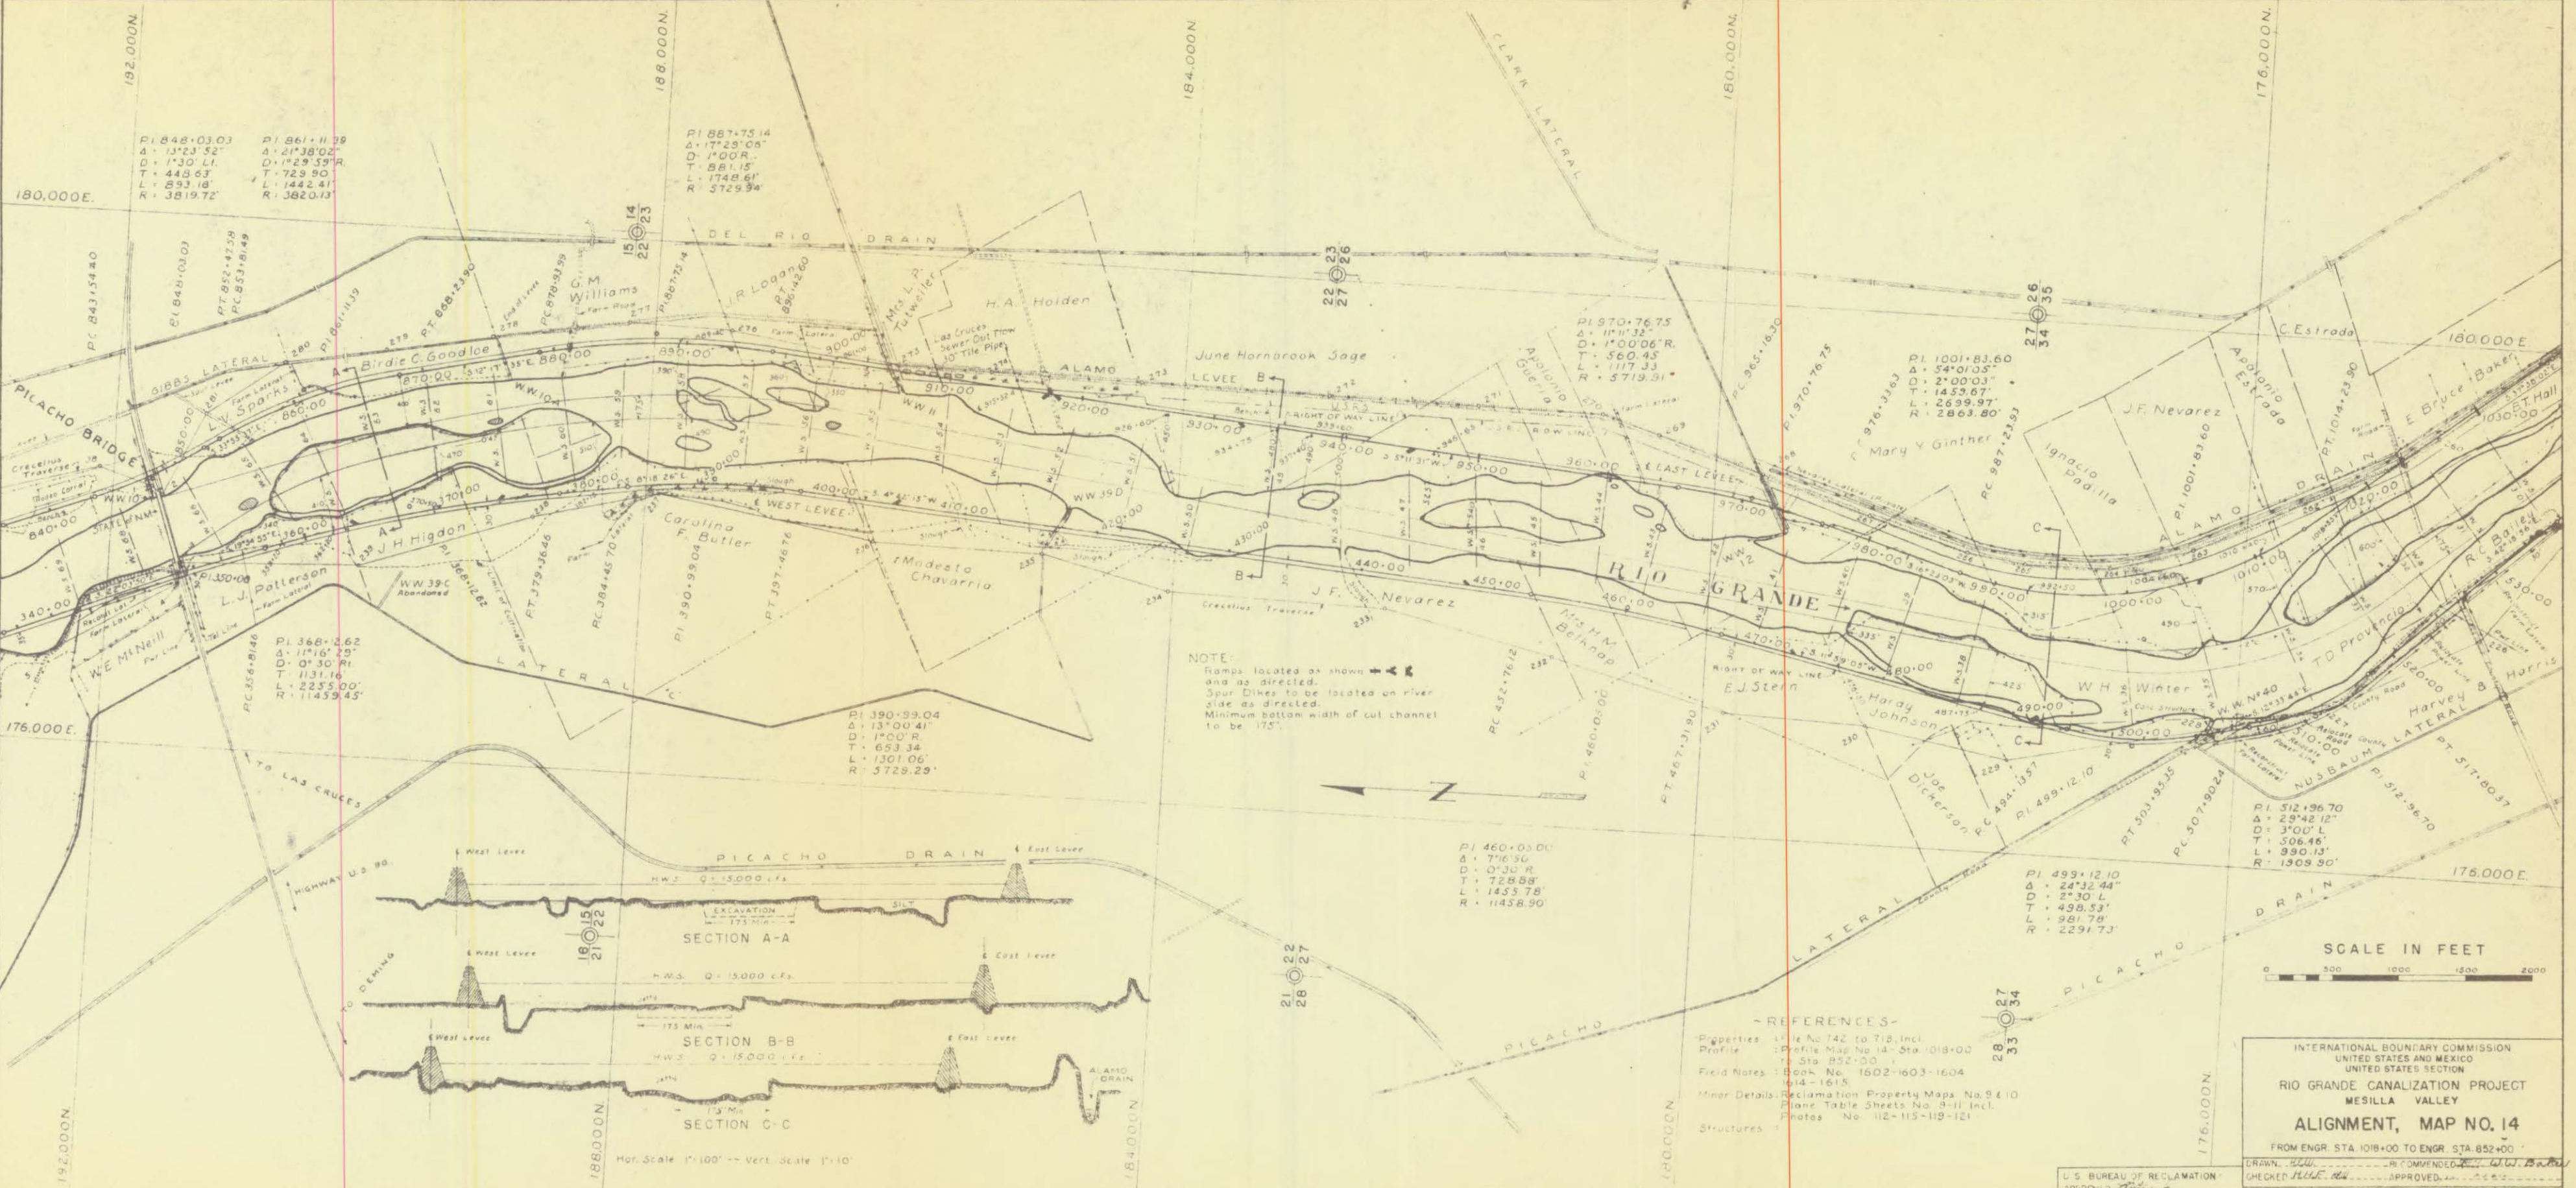

NOTE:  
 Ramps located as shown and as directed.  
 Spur Dikes to be located on river side as directed.  
 Minimum bottom width of cul channel to be 175'.

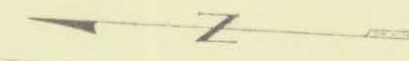

PI 848-03.03  
 Δ = 13°23'52"  
 D = 1'30" L  
 T = 445.63'  
 L = 893.16'  
 R = 3819.72'

PI 861-11.39  
 Δ = 21°38'02"  
 D = 1°29'59" R  
 T = 723.90'  
 L = 1442.41'  
 R = 3820.13'

PI 867-75.14  
 Δ = 17°29'06"  
 D = 1°00' R  
 T = 881.15'  
 L = 1748.61'  
 R = 5729.94'

PI 970-76.75  
 Δ = 11°13'  
 D = 1°00'06" R  
 T = 560.45'  
 L = 1117.33'  
 R = 5719.31'

PI 1001-83.60  
 Δ = 54°01'05"  
 D = 2°00'03"  
 T = 1453.67'  
 L = 2699.97'  
 R = 2863.80'


PI 350-00  
 Δ = 11°16'29"  
 D = 0°30' R  
 T = 1131.16'  
 L = 2255.00'  
 R = 11459.45'

PI 390-99.04  
 Δ = 13°00'41"  
 D = 1°00' R  
 T = 653.34'  
 L = 1301.06'  
 R = 5729.29'

PI 460-05.00  
 Δ = 7°16'50"  
 D = 0°30' R  
 T = 728.88'  
 L = 1455.78'  
 R = 11458.90'

PI 512-96.70  
 Δ = 29°42'12"  
 D = 3°00' L  
 T = 506.46'  
 L = 990.13'  
 R = 1909.90'

PI 499-12.10  
 Δ = 24°32'44"  
 D = 2°30' L  
 T = 498.53'  
 L = 981.78'  
 R = 2291.73'

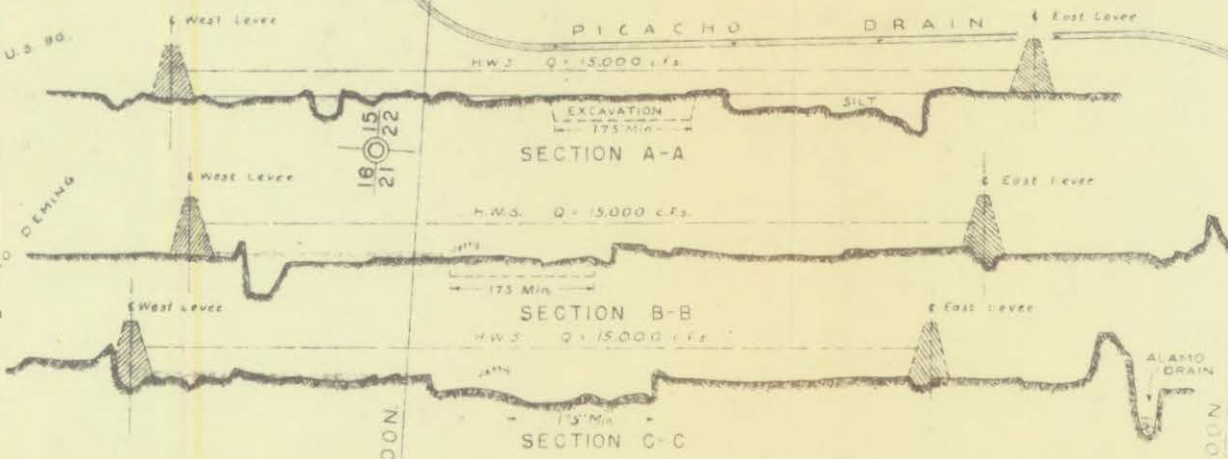

- REFERENCES:
- Properties: Profile No 742 to 718, Incl.
  - Profile: Profile Map No 14 - Sta 1018+00 to Sta 852+00
  - Field Notes: Book No. 1602-1603-1604 1614-1615
  - Minor Details: Reclamation Property Maps No. 9 & 10
  - Plane Table Sheets No. 8-II Incl.
  - Photos: No. 112-115-119-121
  - Structures:

INTERNATIONAL BOUNDARY COMMISSION  
 UNITED STATES AND MEXICO  
 UNITED STATES SECTION


RIO GRANDE CANALIZATION PROJECT  
 MESILLA VALLEY

**ALIGNMENT, MAP NO. 14**

FROM ENGR. STA. 1018+00 TO ENGR. STA. 852+00

U.S. BUREAU OF RECLAMATION  
 DRAWN BY: [Signature] CHECKED BY: [Signature] APPROVED BY: [Signature]

14-15 LAS CRUCES, N.M. - AUG. 31, 1939 3649-38-C

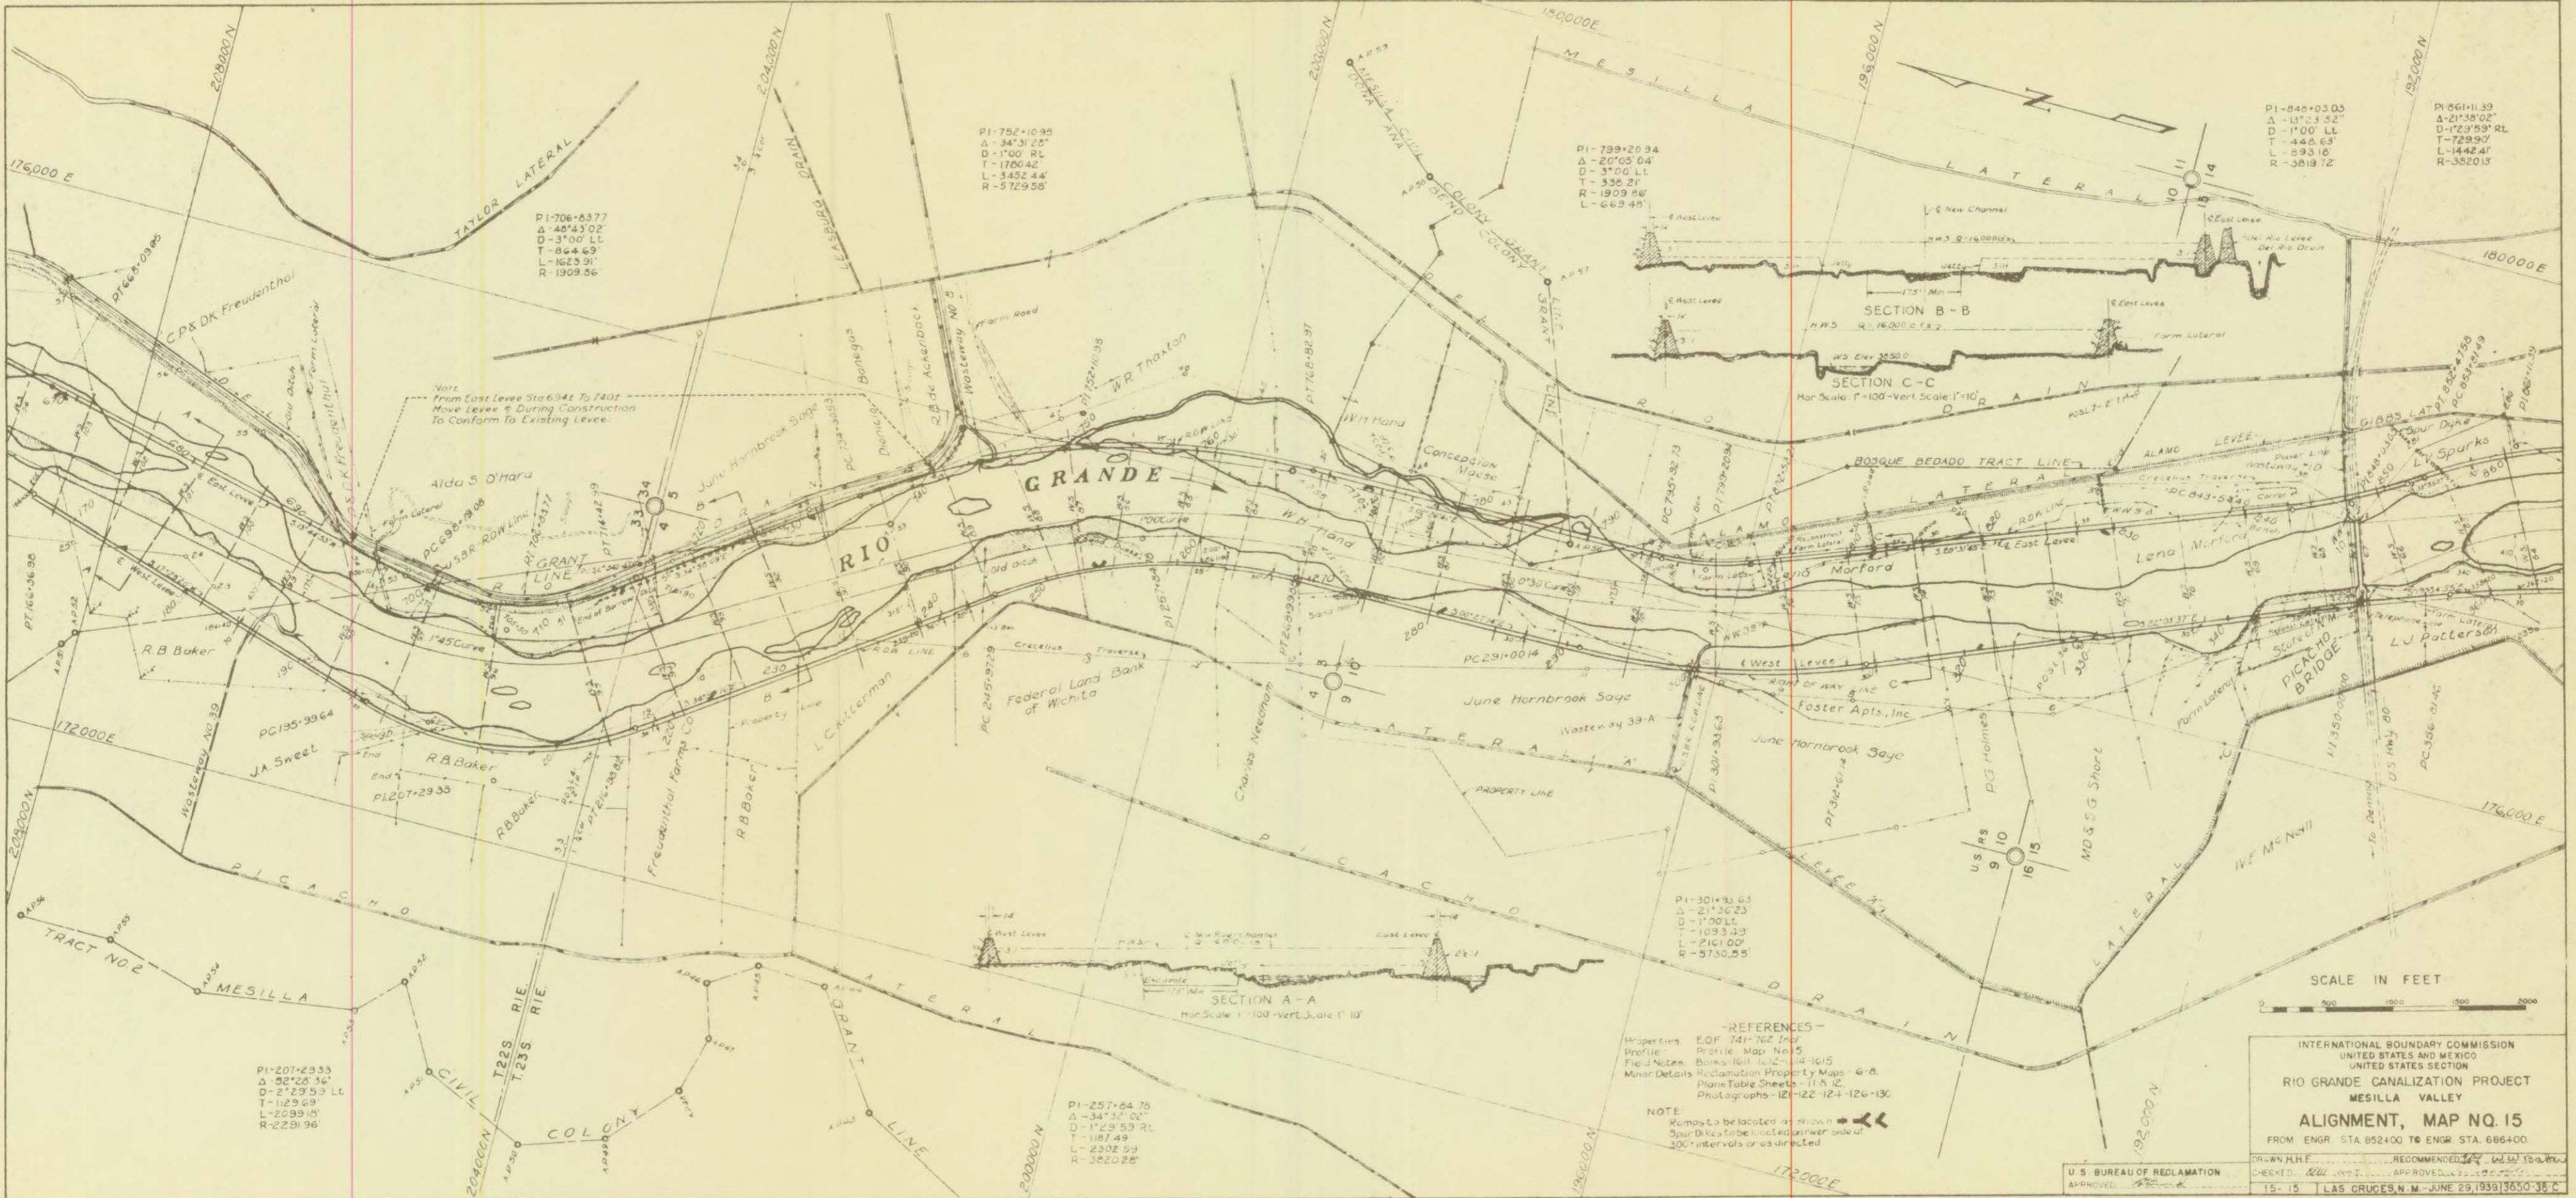

PI-706-8377  
 Δ-48°43'02"  
 D-3°00' Lt  
 T-864.69'  
 L-1623.91'  
 R-1909.56'



PI-752-1099  
 Δ-34°31'26"  
 D-1°00' Rt  
 T-1700.42'  
 L-3452.44'  
 R-5729.58'

PI-799-2034  
 Δ-20°05'04"  
 D-3°00' Lt  
 T-336.21'  
 L-1909.56'  
 R-669.49'

PI-848-0303  
 Δ-13°23'52"  
 D-1°00' Lt  
 T-448.63'  
 L-593.18'  
 R-3819.72'

PI-861-1139  
 Δ-21°38'02"  
 D-1°29'59" Rt  
 T-729.97'  
 L-1442.41'  
 R-3520.15'

Note:  
 Vort from East Levee Sta 6941 To 7401  
 Move Levee & During Construction  
 To Conform To Existing Levee.

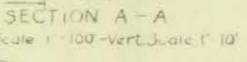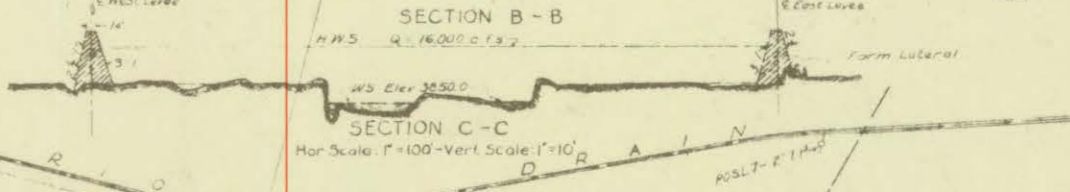

**-REFERENCES-**  
 Properties: E.O.F. 741-762 Invt  
 Profile: Profile Map No. 5  
 Field Notes: Books 1611, 1612, 1613, 1614, 1615  
 Minor Details: Reclamation Property Maps - G-8  
 Plane Table Sheets - 11 & 12  
 Photographs - 121-122-124-126-130

**NOTE**  
 Ramps to be located as shown  
 Spur Dikes to be located on river side of  
 300' intervals or as directed




INTERNATIONAL BOUNDARY COMMISSION  
 UNITED STATES AND MEXICO  
 UNITED STATES SECTION  
**RIO GRANDE CANALIZATION PROJECT**  
 MESILLA VALLEY  
**ALIGNMENT, MAP NO. 15**  
 FROM ENGR. STA. 852400 TO ENGR. STA. 686400.

PI-207-2933  
 Δ-52°28'36"  
 D-2°29'53" Lt  
 T-1129.69'  
 L-2099.18'  
 R-2281.96'

PI-257-8475  
 Δ-34°32'02"  
 D-1°29'53" Rt  
 T-1187.49'  
 L-2302.59'  
 R-3820.25'

PI-301-9365  
 Δ-21°36'23"  
 D-1°00' Lt  
 T-1093.33'  
 L-2161.00'  
 R-5730.55'

U.S. BUREAU OF RECLAMATION  
 APPROVED: [Signature]  
 15-15 LAS CRUCES, N.M. - JUNE 29, 1938 3650-38-C

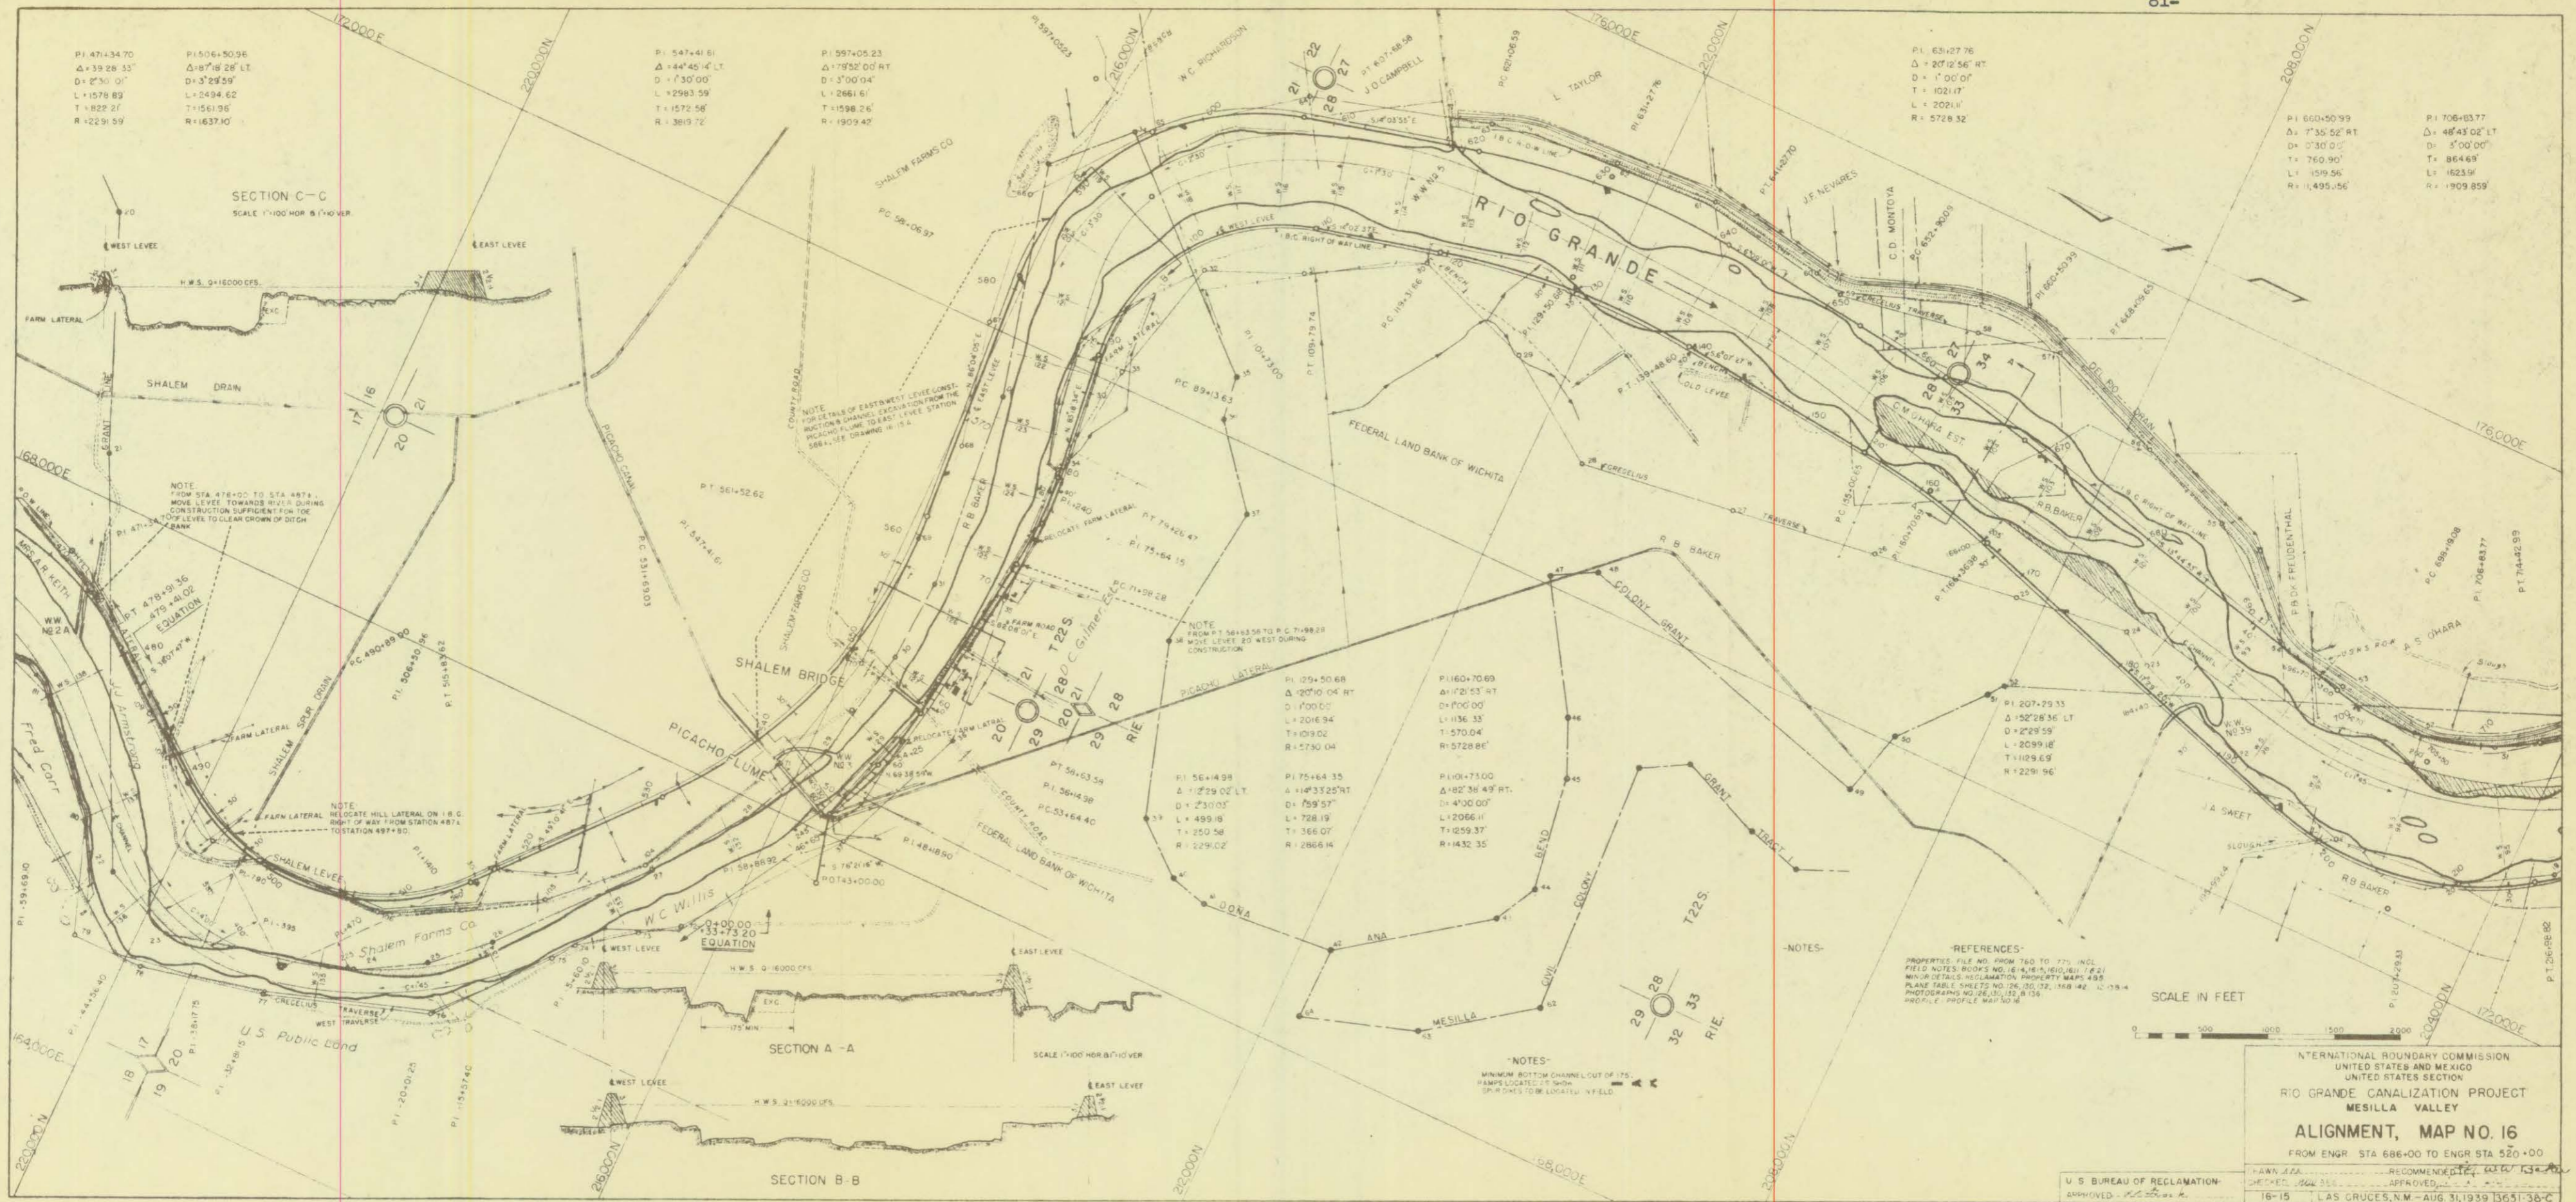


INTERNATIONAL BOUNDARY COMMISSION  
 UNITED STATES AND MEXICO  
 UNITED STATES SECTION  
 RIO GRANDE CANALIZATION PROJECT  
 MESILLA VALLEY  
**ALIGNMENT, MAP NO. 16**  
 FROM ENGR. STA 686+00 TO ENGR. STA 520+00

U.S. BUREAU OF RECLAMATION  
 APPROVED: [Signature]

RECOMMENDED BY: [Signature]  
 APPROVED: [Signature]

16-15 LAS CRUCES, N.M. - AUG. 31, 1939 3651-36-C

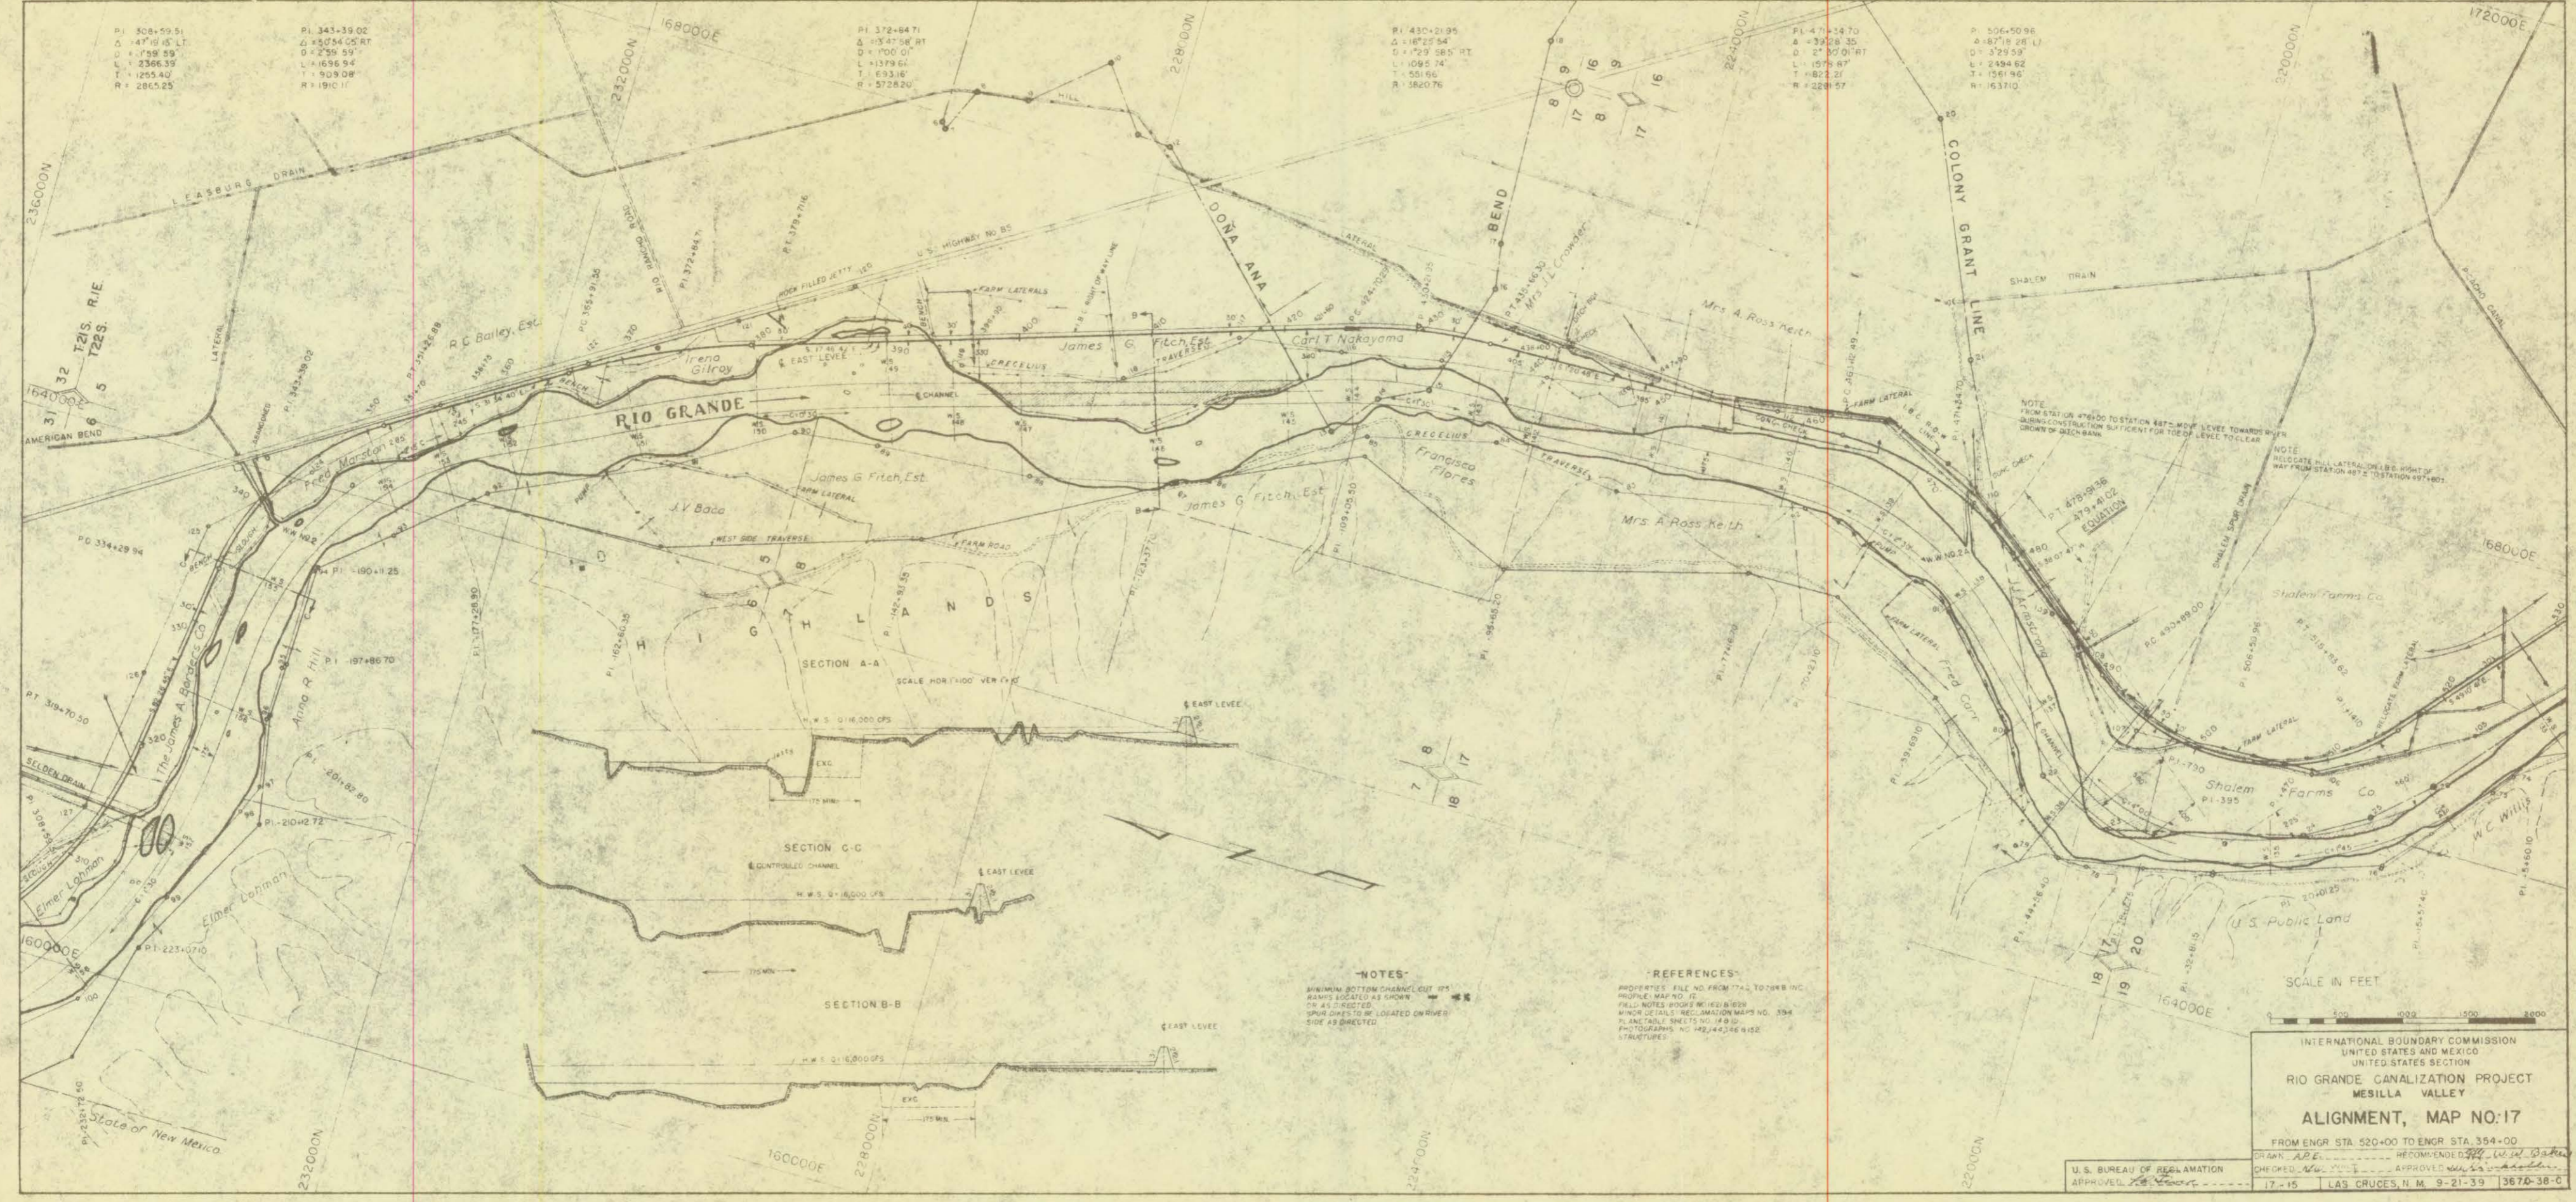

PI 308+59.51  
 Δ = 47° 15' 45" LT  
 D = 1799.59'  
 L = 2366.39'  
 T = 1255.40'  
 R = 2865.25'


PI 343+39.02  
 Δ = 50° 54' 05" RT  
 D = 2259.59'  
 L = 1696.94'  
 T = 909.08'  
 R = 1910.11'

PI 372+64.71  
 Δ = 53° 47' 58" RT  
 D = 1700.01'  
 L = 1379.64'  
 T = 693.16'  
 R = 5728.20'

PI 430+21.95  
 Δ = 18° 25' 54"  
 D = 1723.581 RT  
 L = 1095.74'  
 T = 551.66'  
 R = 3820.76'

PI 470+14.70  
 Δ = 32° 28' 35"  
 D = 2150.01 RT  
 L = 1575.87'  
 T = 822.21'  
 R = 2281.57'


PI 506+50.96  
 Δ = 87° 18' 28" L  
 D = 3729.59'  
 L = 2494.62'  
 T = 1561.96'  
 R = 16371.0'

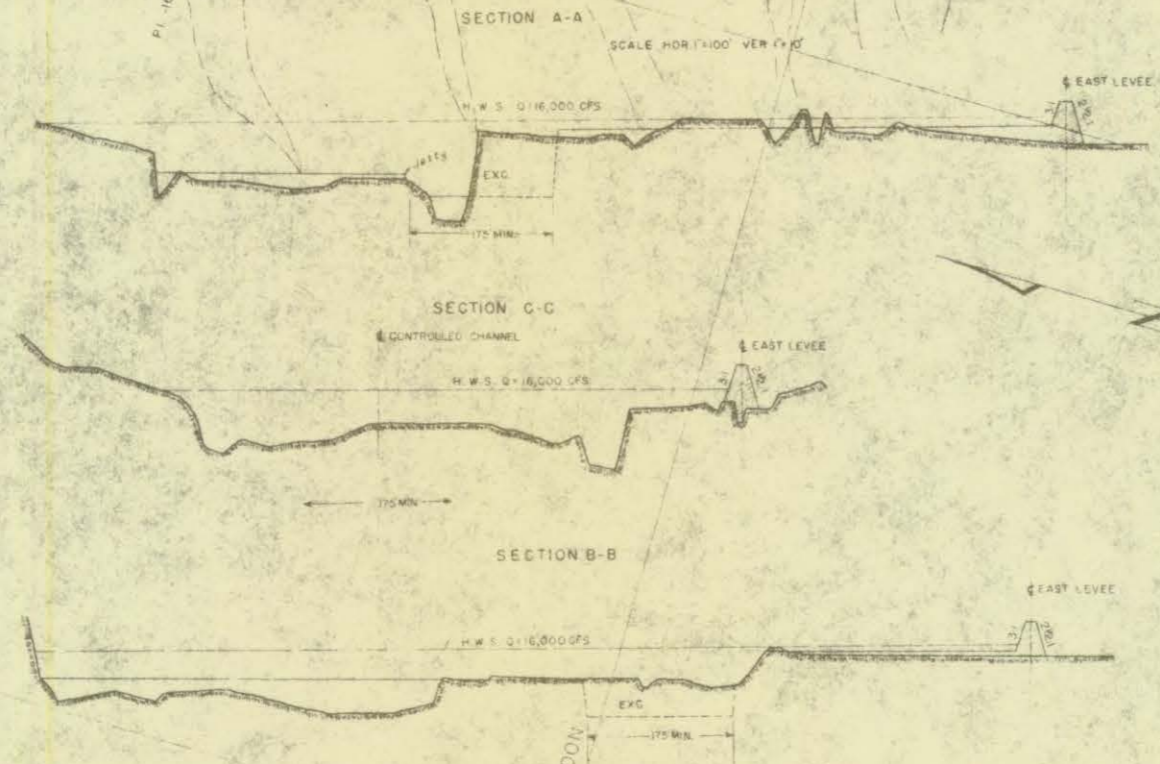

**NOTES**  
 MINIMUM BOTTOM CHANNEL CUT 175  
 FEET LOCATED AS SHOWN  
 OR AS DIRECTED  
 SPUR DIKES TO BE LOCATED ON RIVER  
 SIDE AS DIRECTED

**REFERENCES**  
 PROPERTIES FILE NO. FROM 1742 TO 1788 INC.  
 PROFILE MAP NO. 15  
 FIELD NOTES BOOKS NO. 1628, 1629  
 MINOR DE TAILS RECLAMATION MAPS NO. 334  
 PLANT TABLE SHEETS NO. 149-150  
 PHOTOGRAPHS NO. 142, 143, 146, 152  
 STRUCTURES

INTERNATIONAL BOUNDARY COMMISSION  
 UNITED STATES AND MEXICO  
 UNITED STATES SECTION  
**RIO GRANDE CANALIZATION PROJECT**  
 MESILLA VALLEY  
**ALIGNMENT, MAP NO. 17**  
 FROM ENGR. STA. 520+00 TO ENGR. STA. 354+00  
 DRAWN: ABE  
 CHECKED: W.C. Williams  
 APPROVED: W.C. Williams  
 U.S. BUREAU OF RECLAMATION  
 APPROVED: [Signature]  
 17-15 LAS CRUCES, N. M. 9-21-39 3670-38-C

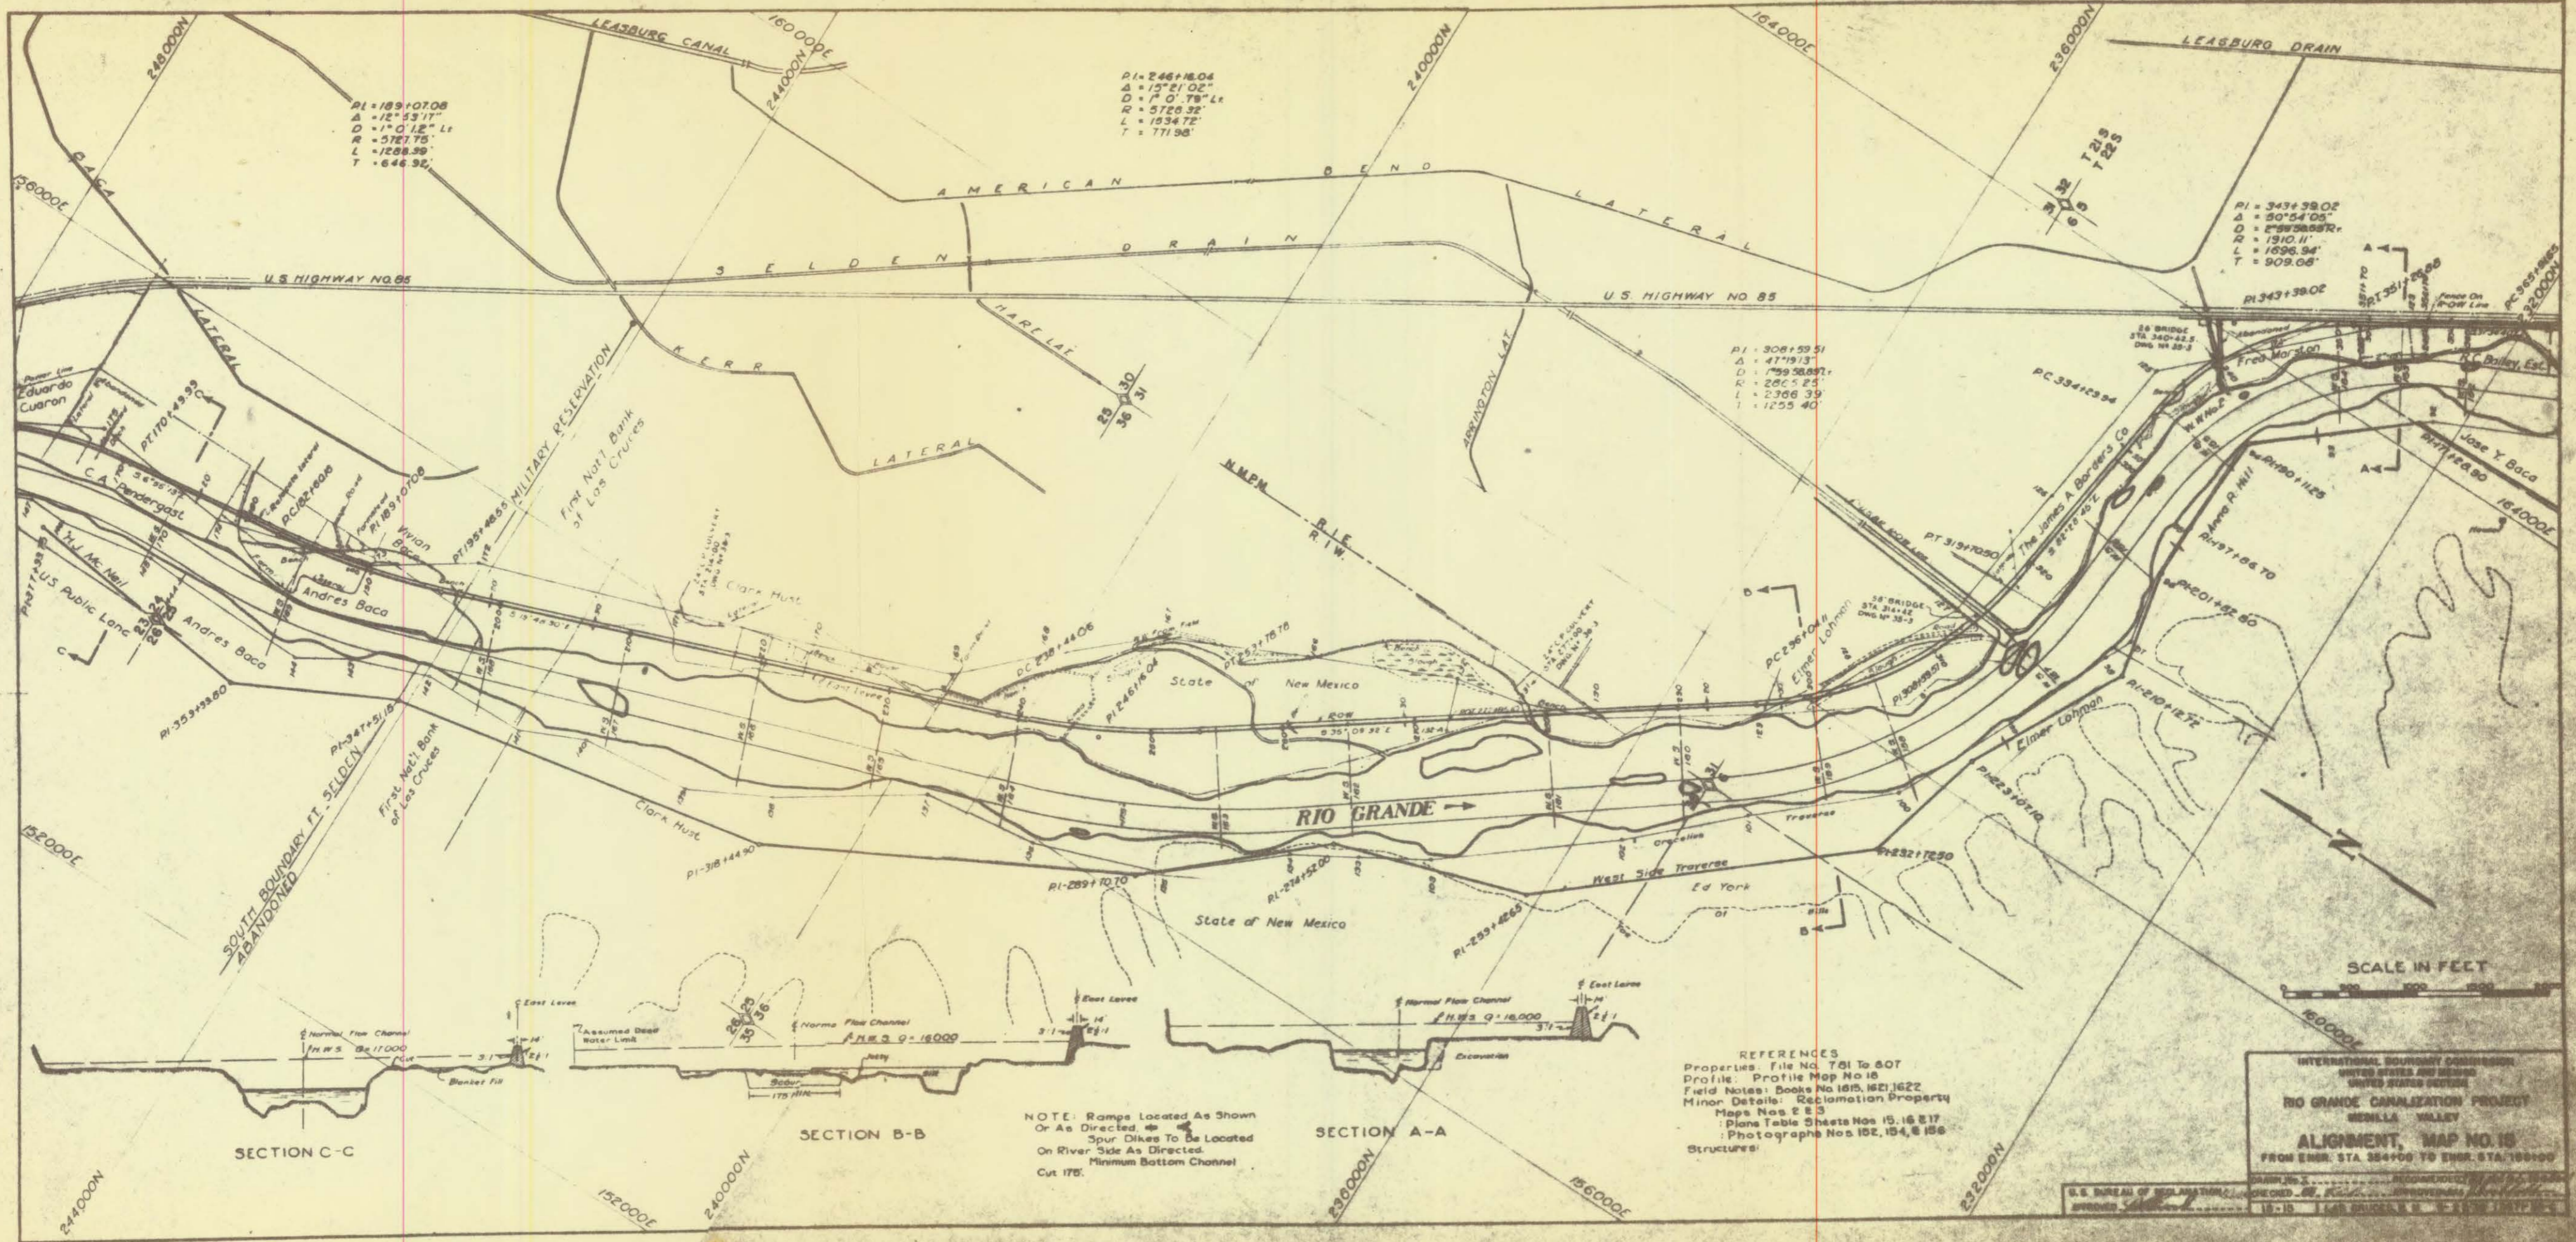

PI = 189+0708  
 Δ = 12° 53' 17"  
 D = 1° 0' 12" Lt  
 R = 5721.75'  
 L = 1208.39'  
 T = 646.32'

PI = 246+1604  
 Δ = 15° 21' 02"  
 D = 1° 0' 78" Lt  
 R = 5726.32'  
 L = 1534.72'  
 T = 771.98'

PI = 343+3802  
 Δ = 30° 54' 05"  
 D = 2° 59' 08" R  
 R = 1310.11'  
 L = 1696.94'  
 T = 909.06'


PI = 308+5951  
 Δ = 47° 19' 13"  
 D = 1° 59' 38.897" R  
 R = 2665.25'  
 L = 2368.39'  
 T = 1255.40'

**REFERENCES**  
 Properties: File No. 751 To 807  
 Profile: Profile Map No. 18  
 Field Notes: Books No. 1615, 1621, 1622  
 Minor Details: Reclamation Property  
 Maps Nos. E E 3  
 Plans Table Sheets Nos. 15, 16, 17  
 Photographs Nos. 152, 154, 156  
 Structures:

**NOTE:** Ramps Located As Shown  
 Or As Directed in  
 Spur Dikes To Be Located  
 On River Side As Directed.  
 Minimum Bottom Channel  
 Cut 178'

INTERNATIONAL BOUNDARY COMMISSION  
 UNITED STATES AND MEXICO  
 UNITED STATES SECTION  
**RIO GRANDE CANALIZATION PROJECT**  
 MESILLA VALLEY  
**ALIGNMENT, MAP NO. 18**  
 FROM ENR. STA. 354+00 TO ENR. STA. 100+00

U.S. BUREAU OF RECLAMATION  
 CHECKED BY: [Signature]  
 APPROVED BY: [Signature]  
 18-15

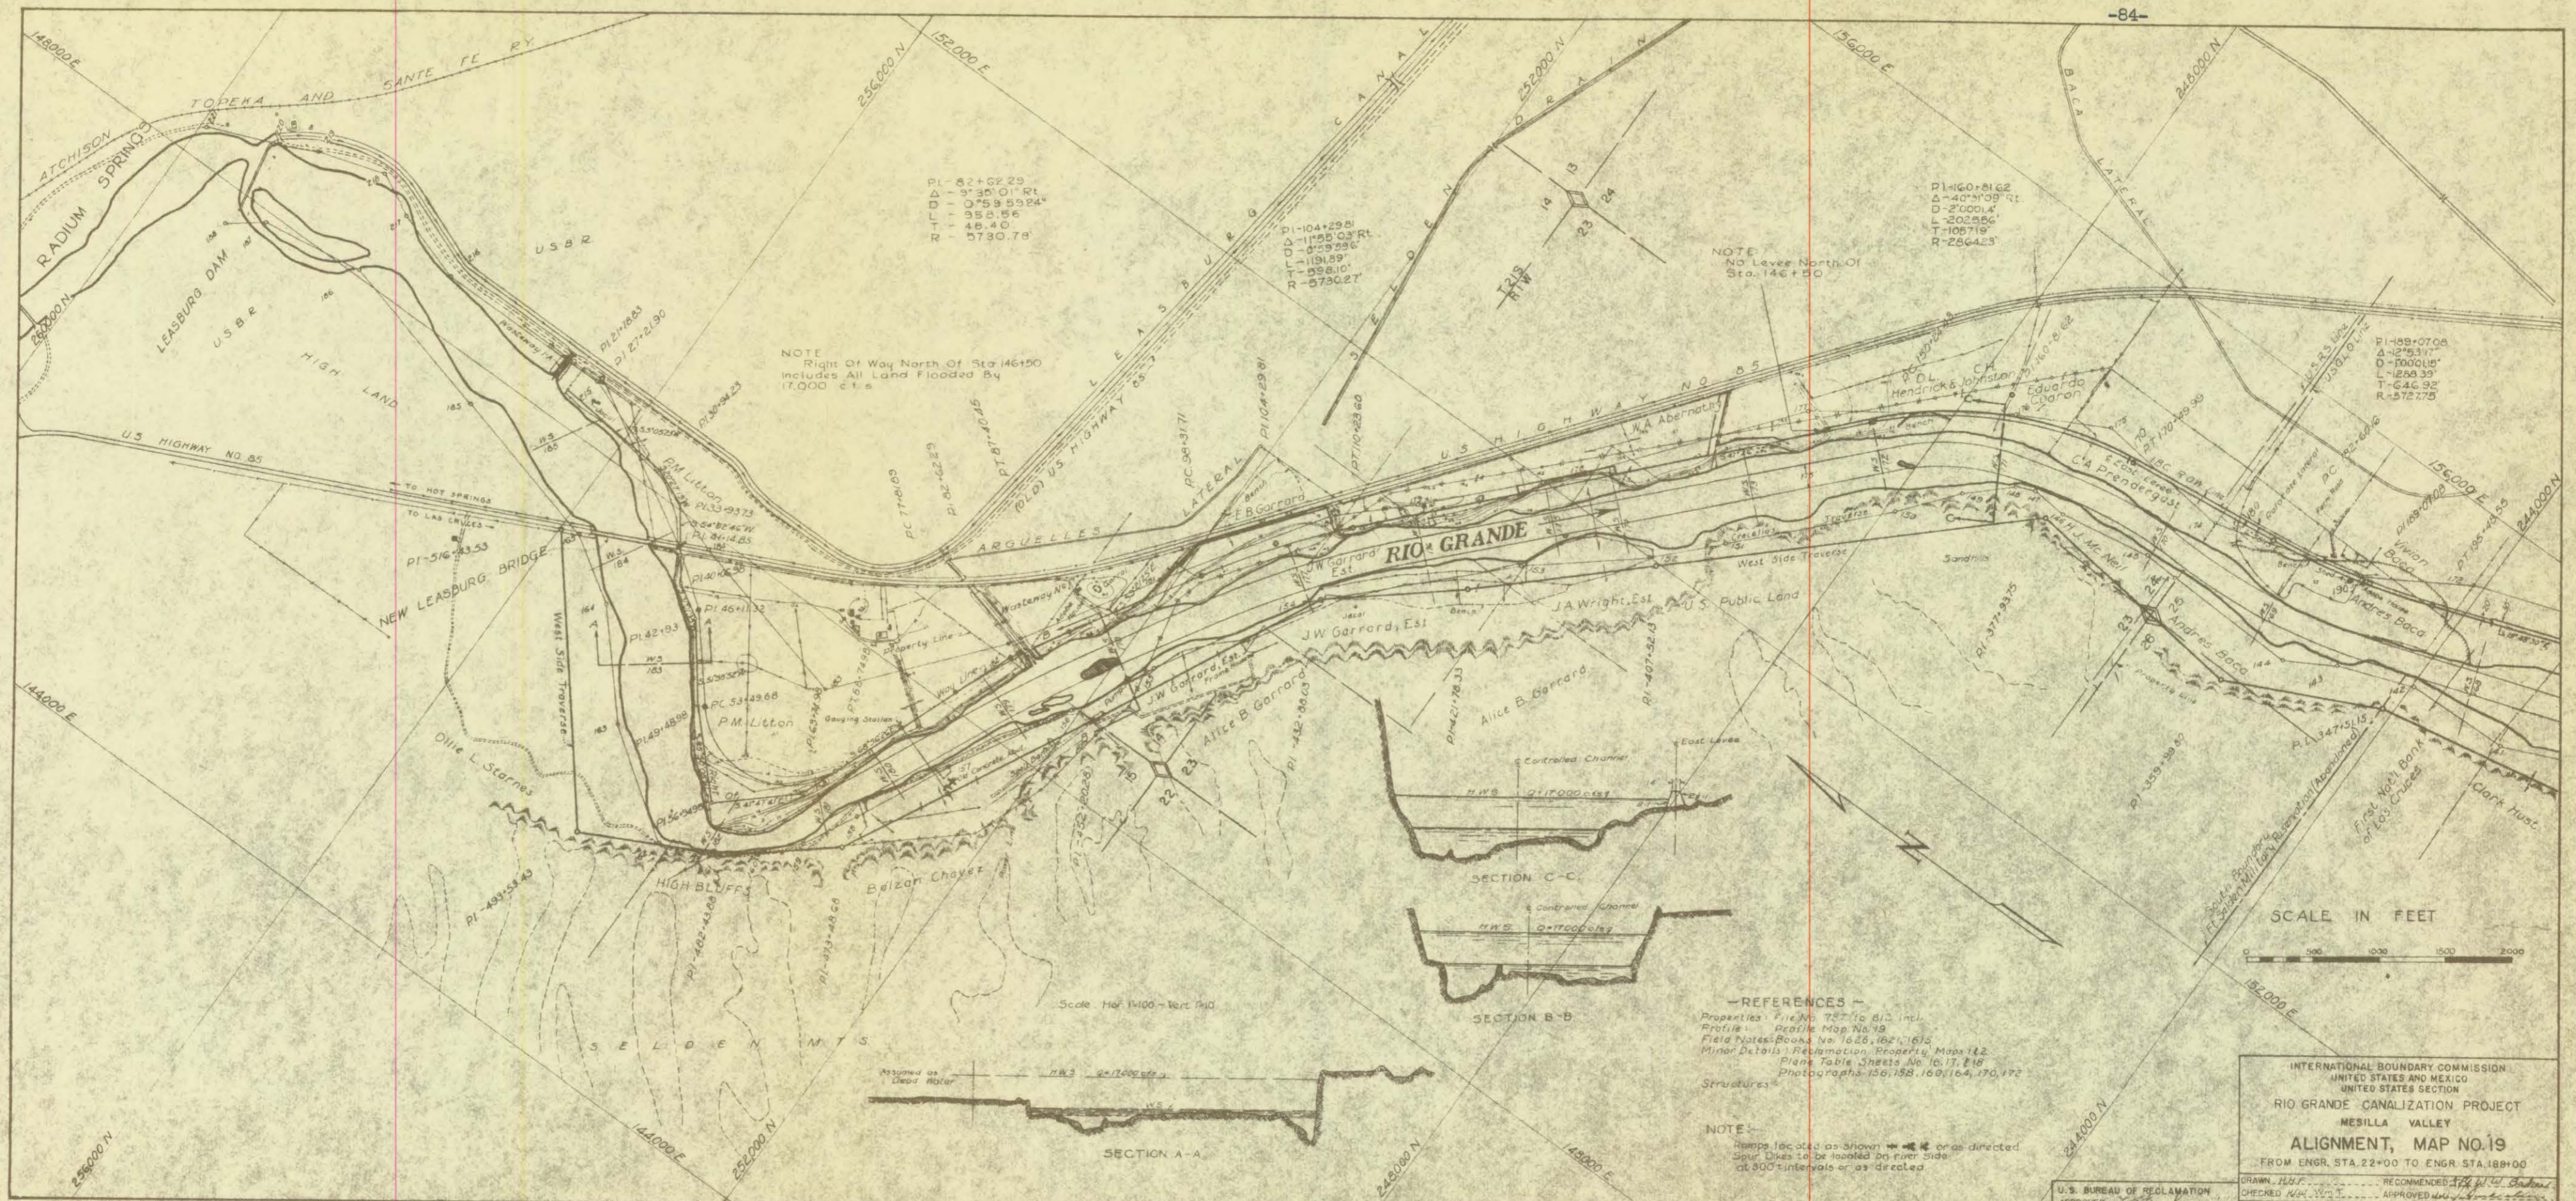

NOTE  
Right of Way North Of Sta 146150  
Includes All Land Flooded By  
17,000 c.f.s

NOTE  
No Level North Of  
Sta. 146150


PI-82+62.29  
Δ-3°35'01" Rt  
D-10°59'59.24"  
L-958.56  
T-48.40  
R-5730.78

PI-104+29.81  
Δ-1°55'03" Rt  
D-1°59'59.6"  
L-1191.89  
T-598.10  
R-5730.27

PI-160+81.62  
Δ-40°10'09" Rt  
D-2°00'04"  
L-2025.56  
T-1057.19  
R-2564.23

PI-189+07.04  
Δ-2°53'17"  
D-1°00'01.5"  
L-1258.39  
T-646.92  
R-5727.75

SCALE IN FEET

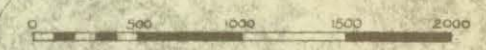

REFERENCES

- Properties: File No. 757 to 812, incl.
- Profile: Profile Map No. 19
- Field Notes: Books No. 1625, 1621, 1615
- Minor Details: Reclamation Property Maps 142
- Plant Table: Sheets No. 16, 17, 218
- Photographs: 156, 158, 160, 164, 170, 172
- Structures: -


NOTE

Ramps located as shown or as directed  
Spur Dikes to be located on river side  
at 300' intervals or as directed

INTERNATIONAL BOUNDARY COMMISSION  
UNITED STATES AND MEXICO  
UNITED STATES SECTION  
RIO GRANDE CANALIZATION PROJECT  
MESILLA VALLEY  
ALIGNMENT, MAP NO. 19  
FROM ENGR. STA. 22+00 TO ENGR. STA. 189+00

U.S. BUREAU OF RECLAMATION  
DRAWN BY: [Signature]  
CHECKED BY: [Signature]  
APPROVED BY: [Signature]  
19-15 LAS CRUCES, N. M. 9-27-39 3672-38-C




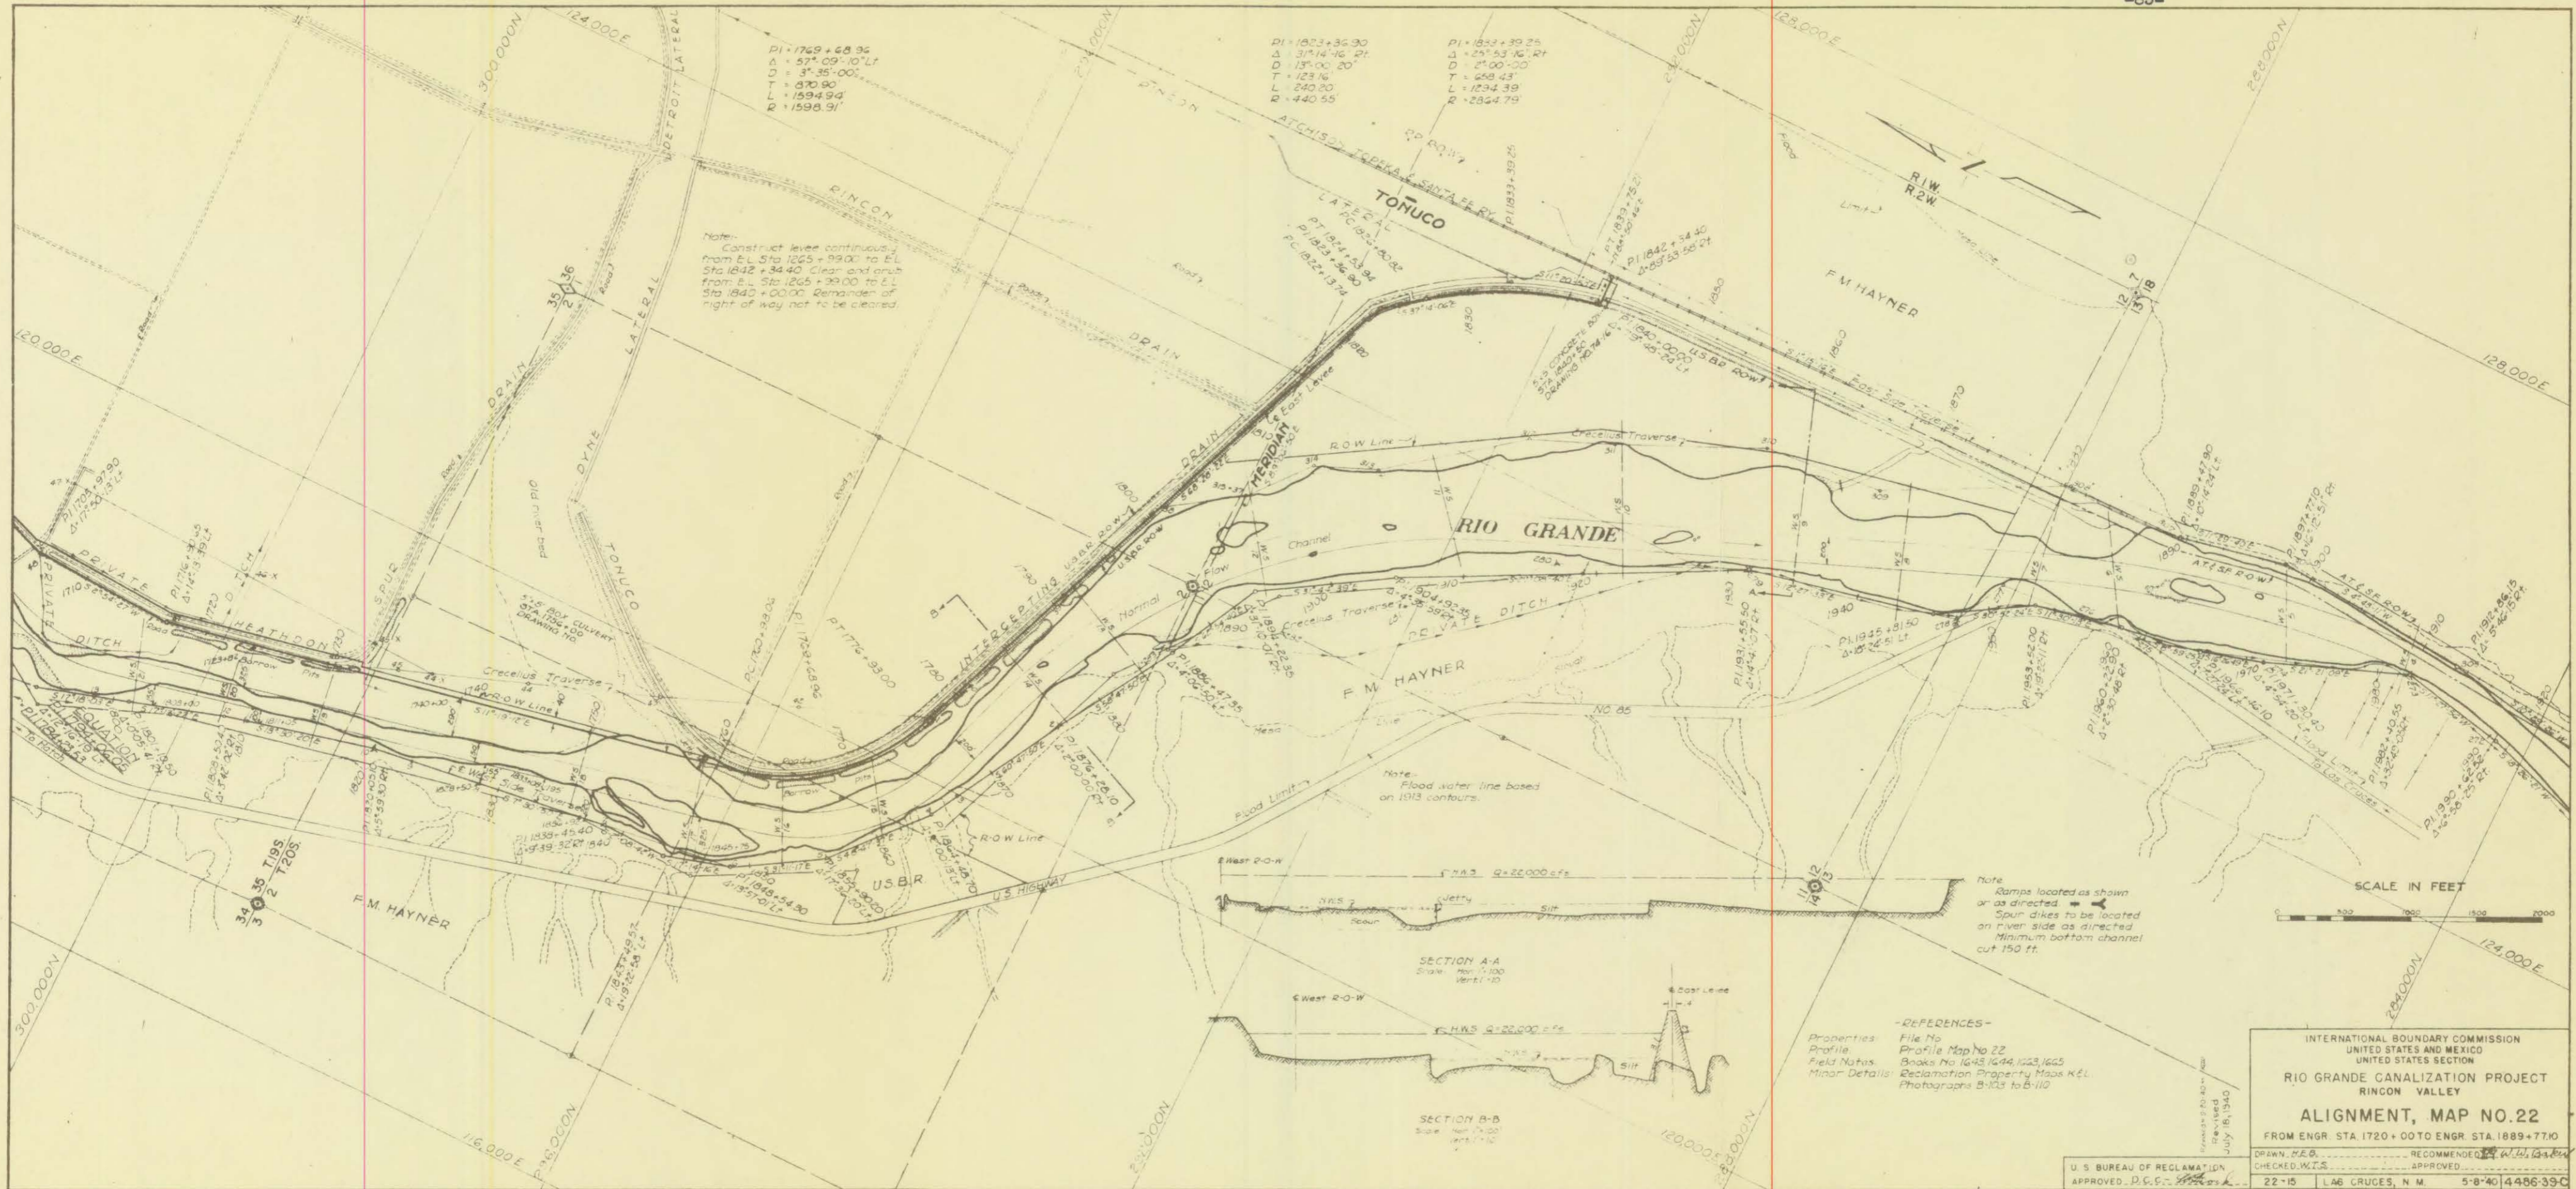

Note:  
Construct levee continuously  
from E.L. Sta 1265+99.00 to E.L.  
Sta 1842+34.40 Clear and grub  
from E.L. Sta 1265+99.00 to E.L.  
Sta 1840+00.00 Remainder of  
right of way not to be cleared.

Note:  
Flood water line based on  
1913 contours.


Note:  
Ramps located as shown  
or as directed.   
Spur dikes to be located  
on river side as directed.  
Minimum bottom channel  
cut 150 ft.

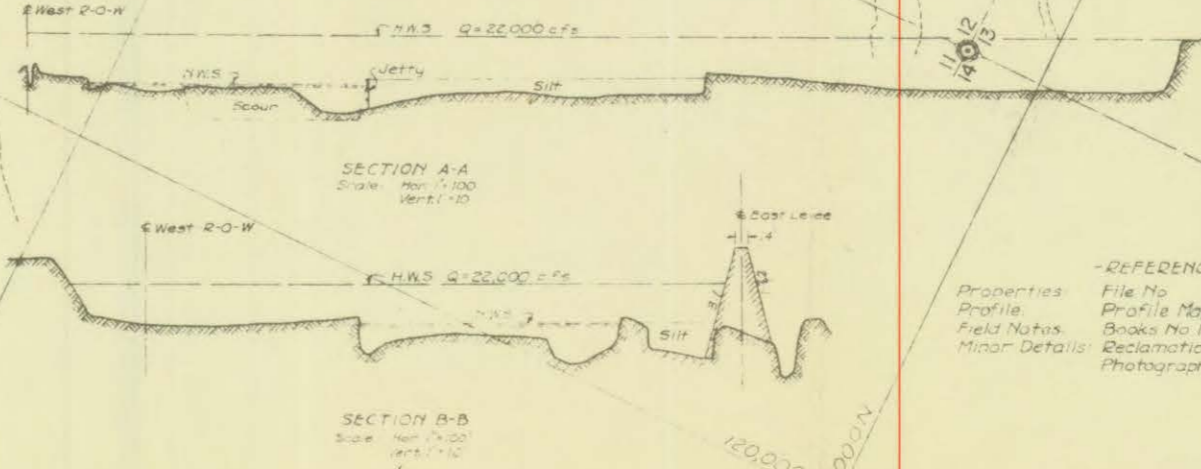

REFERENCES-  
Properties: File No.  
Profile: Profile Map No 22  
Field Notes: Books No 1643, 1644, 1623, 1665  
Minor Details: Reclamation Property Maps K&L,  
Photographs B-103 to B-110

INTERNATIONAL BOUNDARY COMMISSION  
UNITED STATES AND MEXICO  
UNITED STATES SECTION  
**RIO GRANDE CANALIZATION PROJECT**  
RINCON VALLEY  
**ALIGNMENT, MAP NO.22**  
FROM ENGR. STA 1720+00 TO ENGR. STA. 1889+77.10

U.S. BUREAU OF RECLAMATION  
APPROVED:   
DRAWN: M.E.B. RECOMMENDED:   
CHECKED: W.T.S. APPROVED:   
22-15 LAG CRUCES, N.M. 5-8-40 4486-39C

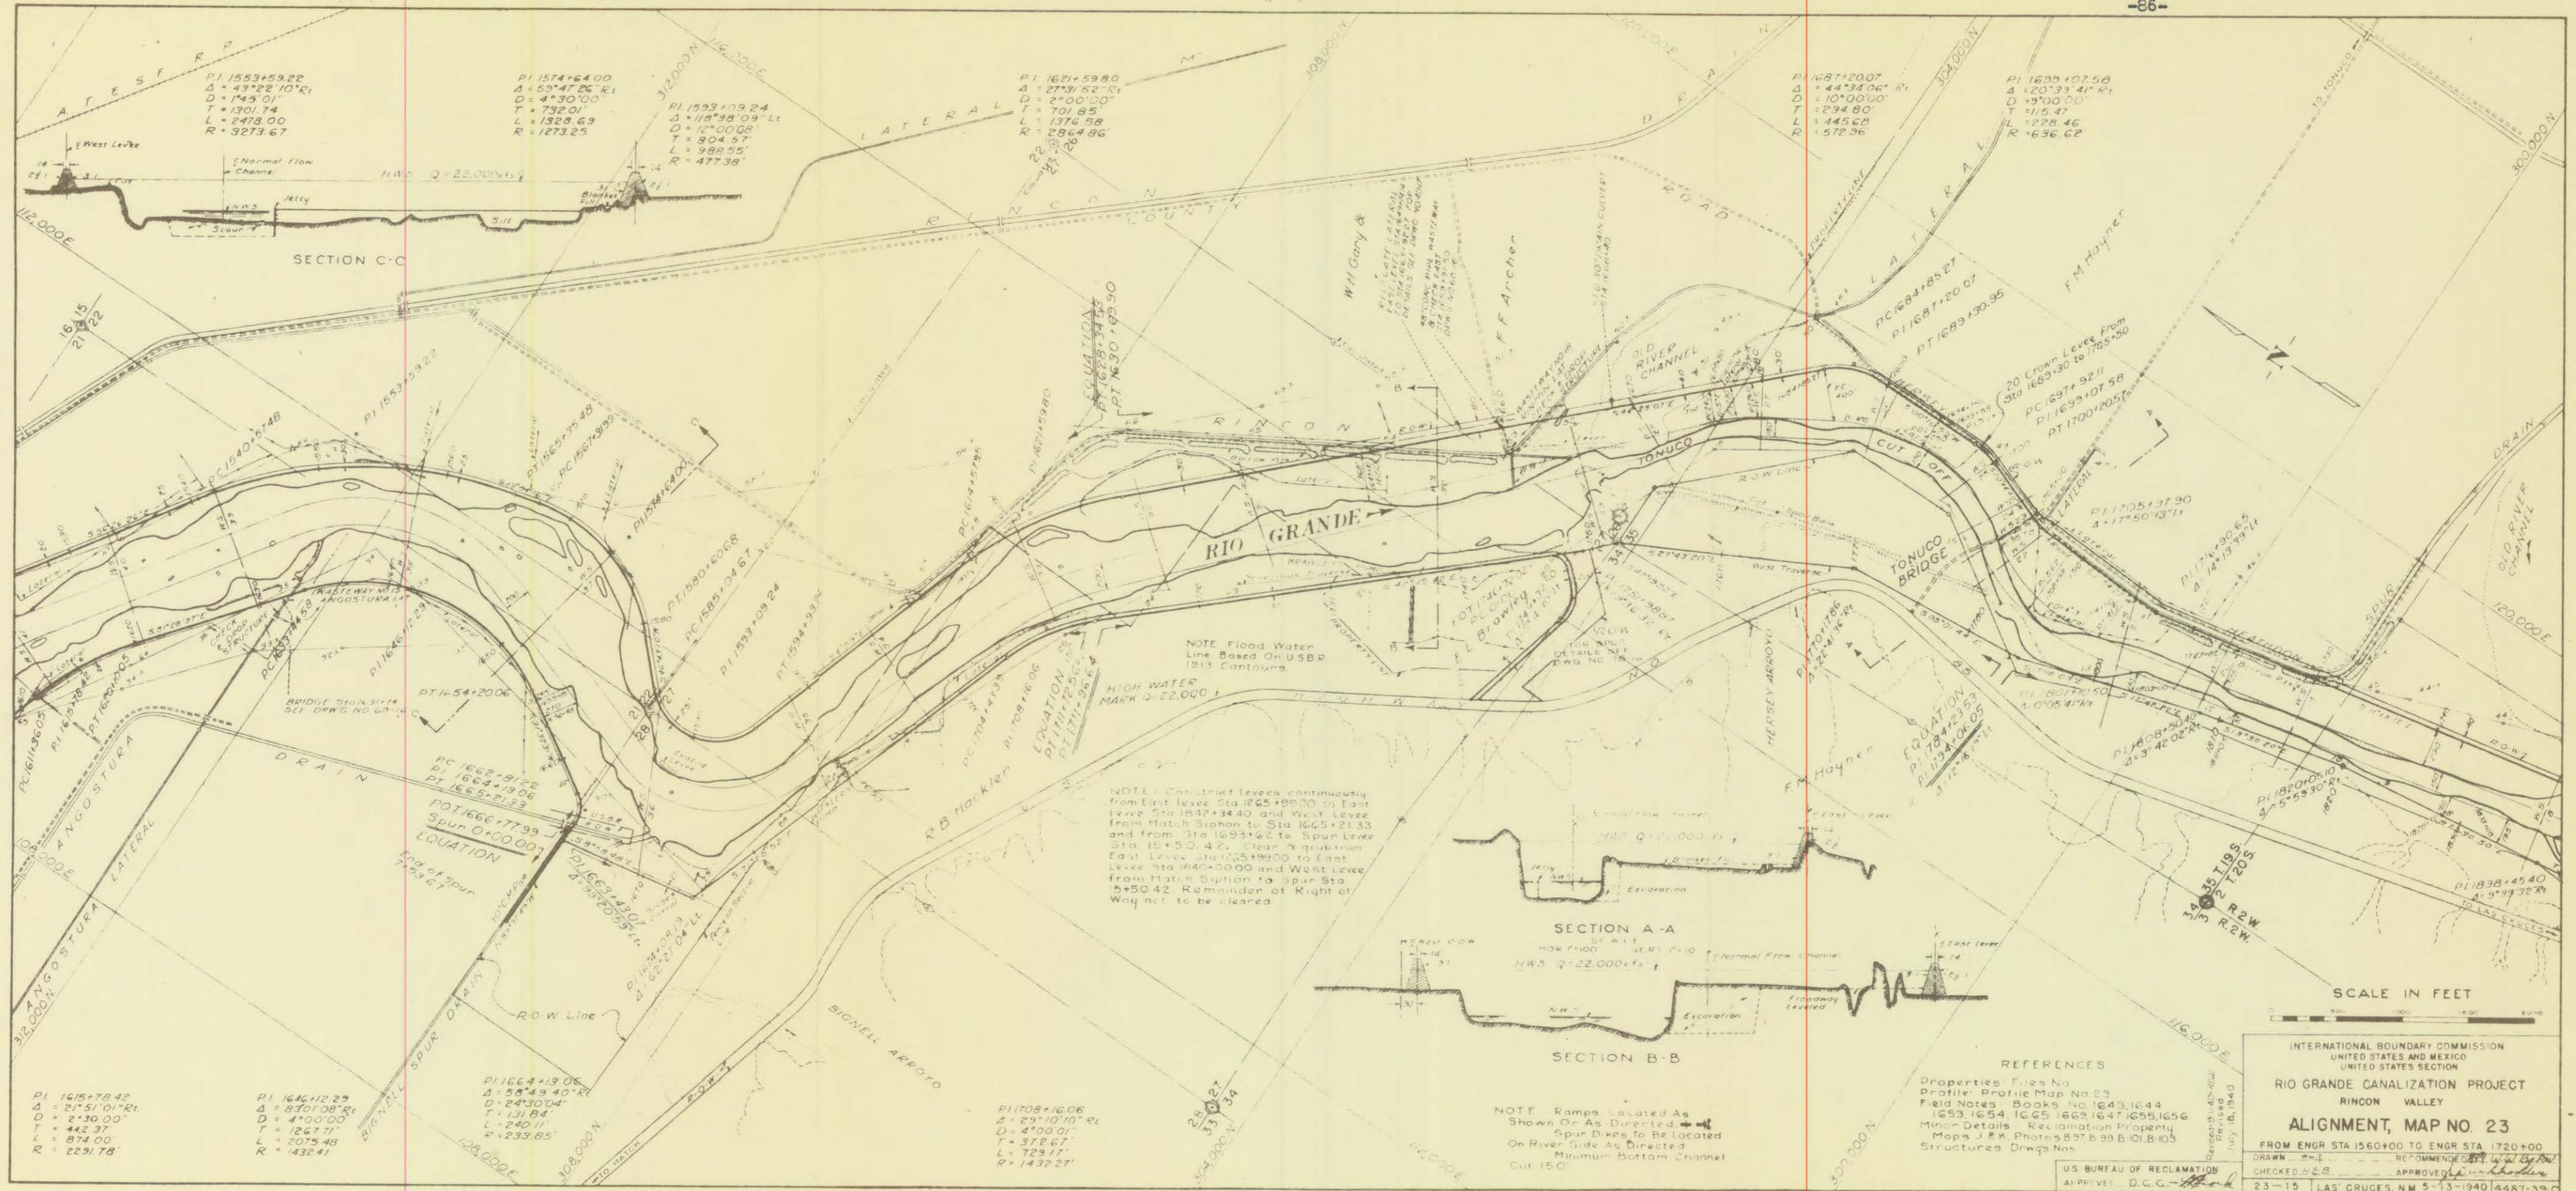

SECTION C-C

SECTION A-A

SECTION B-B

NOTE Flood Water Line Based On USBR 1813 Contours

NOTE: Construct levees continuously from East Levee Sta 1245+99.00 to East Levee Sta 1847+34.40 and West Levee from Hatch Siphon to Sta 1665+21.33 and from Sta 1693+62 to Spur Levee Sta 15+50.42. Clean & grub from East Levee Sta 1225+99.00 to East Levee Sta 1640+50.00 and West Levee from Hatch Siphon to Spur Sta 15+50.42. Remainder of Right of Way not to be cleared.

SCALE IN FEET

0 500 1000 1500 2000

REFERENCES

Properties: Files No. Profile: Profile Map No. 23 Field Notes: Books No. 1643, 1644, 1653, 1654, 1665, 1669, 1647, 1655, 1656 Minor Details: Reclamation Property Maps J & K, Photos B 97, B 99, B 101, B 105 Structures: Drawings Nos.

INTERNATIONAL BOUNDARY COMMISSION  
UNITED STATES AND MEXICO  
UNITED STATES SECTION

**RIO GRANDE CANALIZATION PROJECT**  
RINCON VALLEY

**ALIGNMENT, MAP NO. 23**

FROM ENGR STA 1560+00 TO ENGR STA 1720+00

DRAWN: [Signature] RECOMMENDED BY: [Signature]  
CHECKED: H.E.B. APPROVED: [Signature]

23-15 LAS CRUCES, N.M. 5-13-1940 4487-39-C

NOTE Ramps Located As Shown Or As Directed. Spur Dams To Be Located On River Side As Directed. Minimum Bottom Channel Cut: 15'

PI 1615+78.42  
Δ = 27°51'01" R  
D = 2'30'00"  
T = 442.37  
L = 874.00  
R = 2291.78'

PI 1646+12.29  
Δ = 83°01'08" R  
D = 4'00'00"  
T = 1267.71  
L = 2075.48  
R = 1432.41

PI 1664+13.06  
Δ = 58°49'40" R  
D = 24'30"04"  
T = 131.84'  
L = 240.11'  
R = 233.85'

PI 1708+16.06  
Δ = 29°10'10" R  
D = 4'00'01"  
T = 372.67'  
L = 729.17'  
R = 1432.27'

PI 1687+20.07  
Δ = 44°34'06" R  
D = 10'00'00"  
T = 294.80'  
L = 445.68'  
R = 572.96'

PI 1699+07.58  
Δ = 20°33'41" R  
D = 9'00'00"  
T = 115.47'  
L = 228.46'  
R = 656.62'

PI 1574+64.00  
Δ = 59°47'26" R  
D = 4'30'00"  
T = 732.01'  
L = 1928.69'  
R = 1273.25'




PI 1593+09.24  
Δ = 118°38'09" L  
D = 12'00'08"  
T = 804.57'  
L = 988.55'  
R = 477.38'

PI 1621+59.80  
Δ = 27°31'52" R  
D = 2'00'00"  
T = 701.85'  
L = 1376.58'  
R = 2864.86'






Note: Construct the West Levee continuously thru the reach of river shown by this alignment sheet. Clear and Grub thru above reach only; East location is for Right-of-Way purchase only.

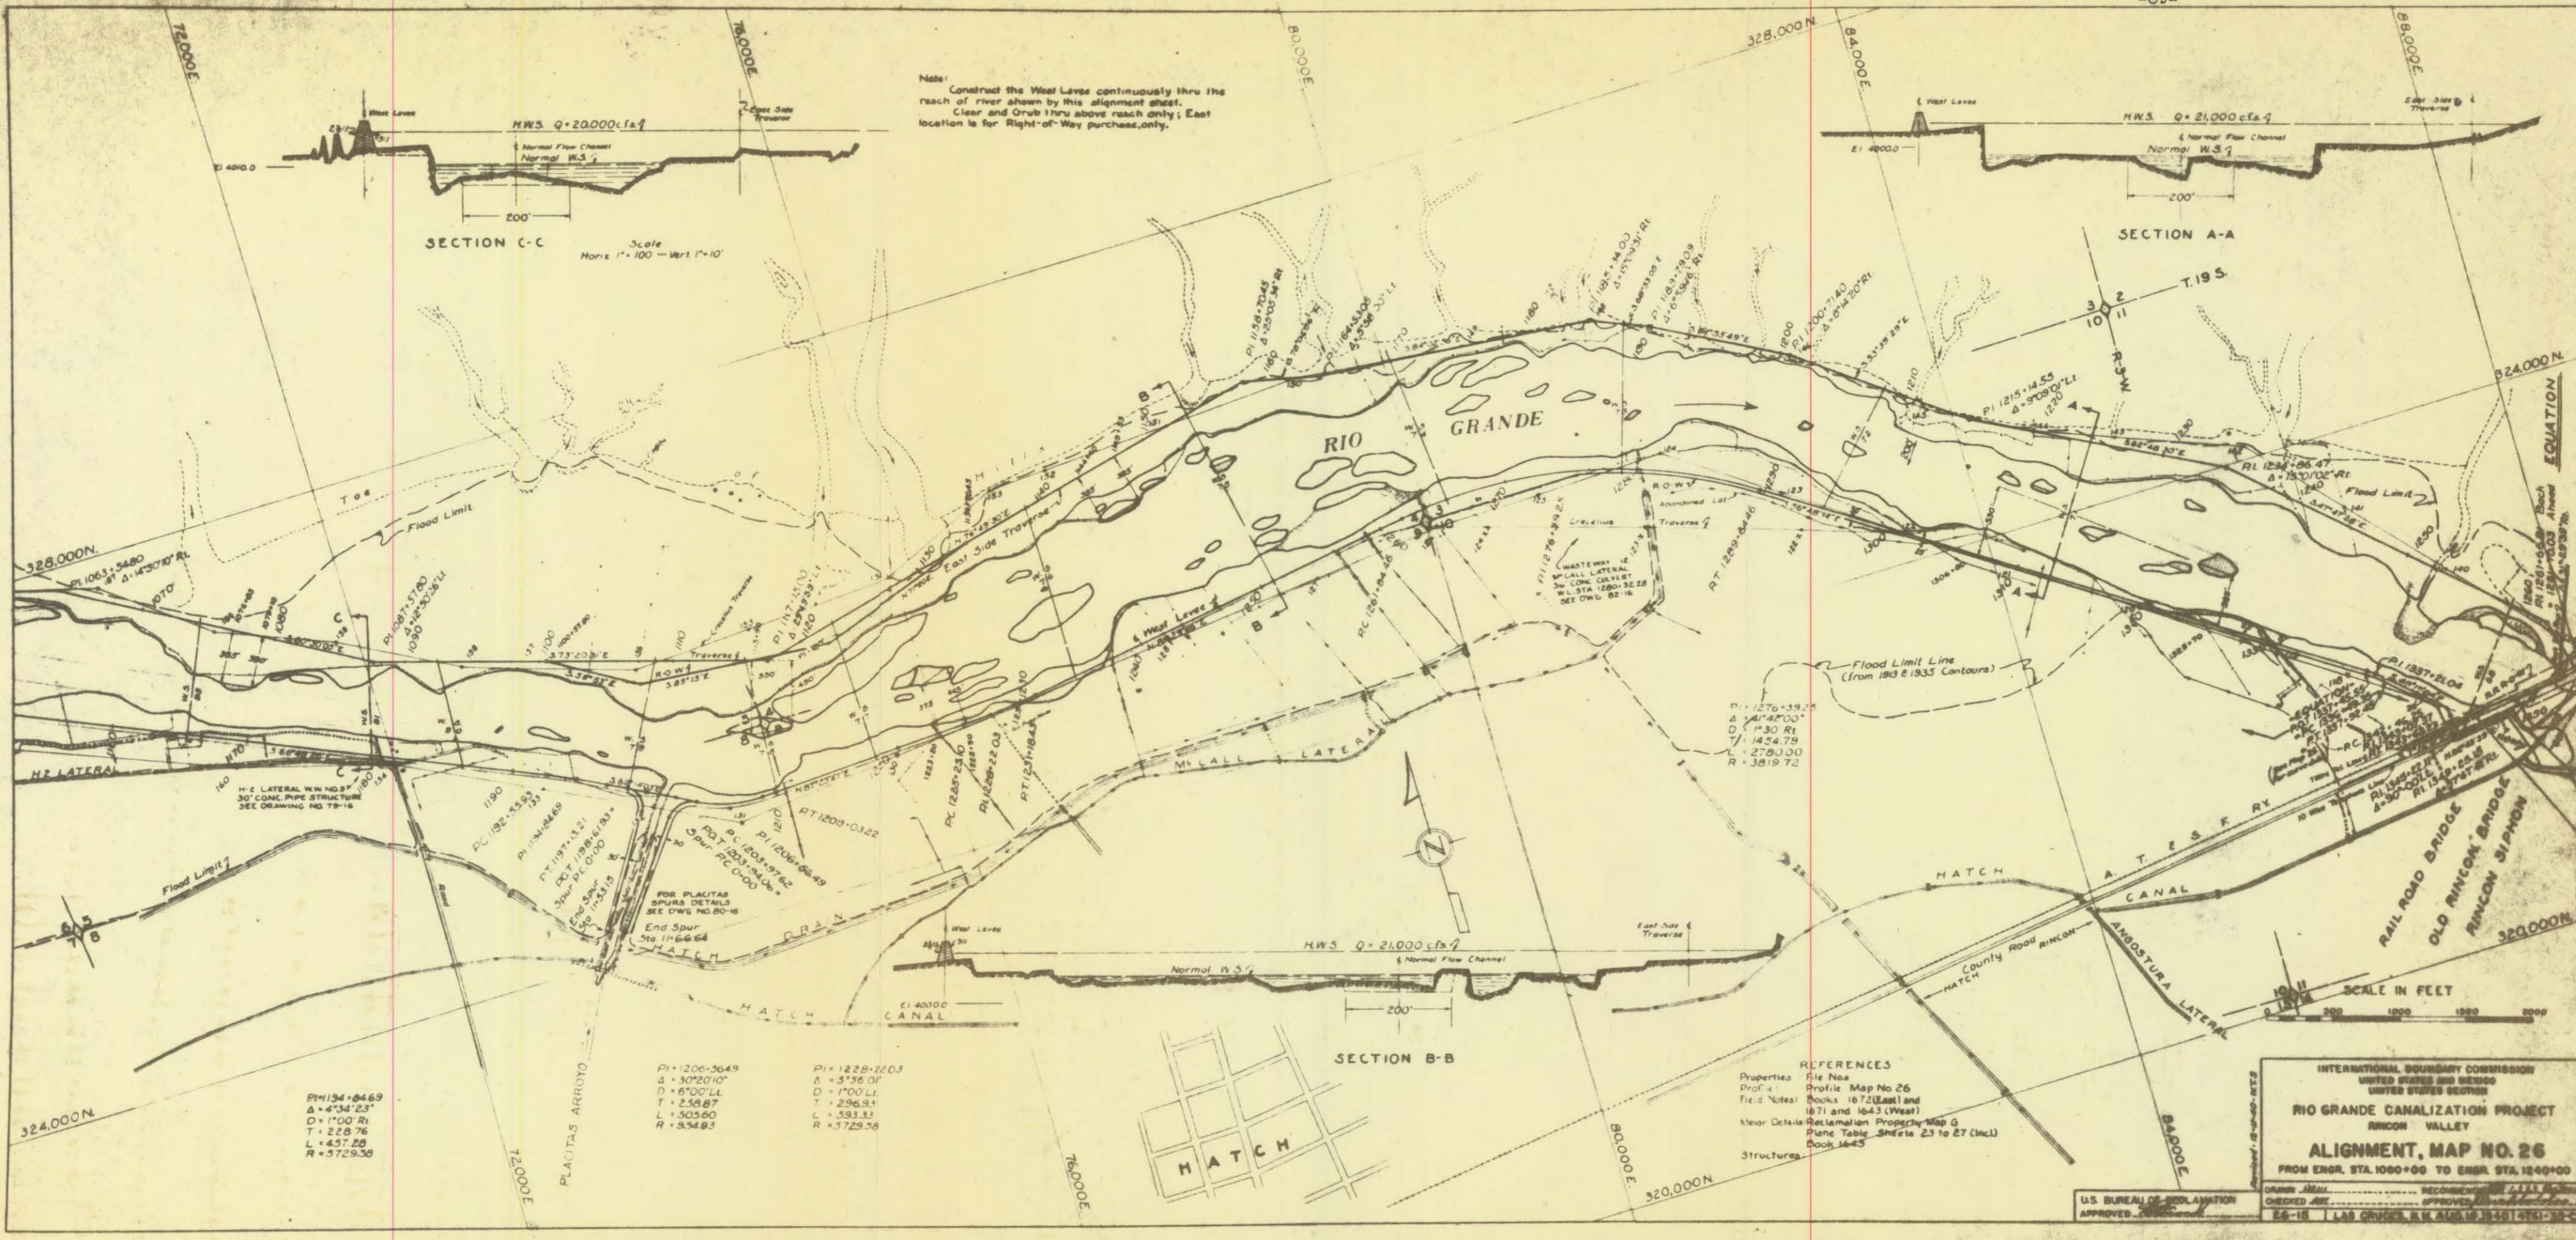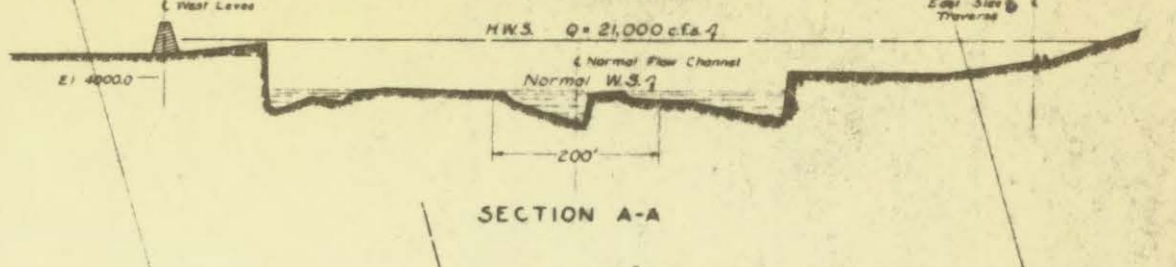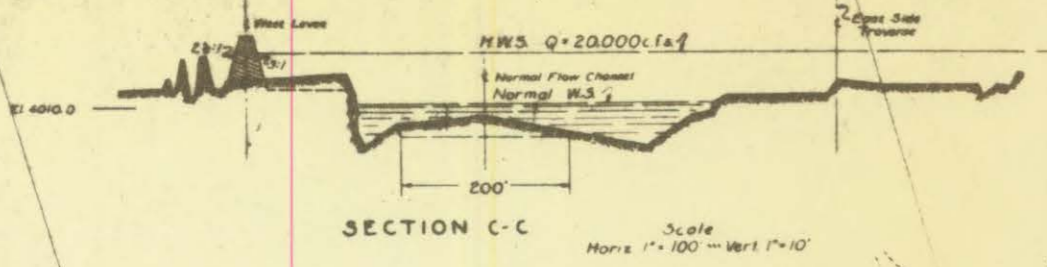

PI=1134+04.69  
Δ=4°34'23"  
D=1°00' Rl  
T=228.76  
L=457.28  
R=5729.58

PI=1206+56.49  
Δ=30°20'10"  
D=6°00' Lr  
T=256.87  
L=505.60  
R=3549.3

PI=1228+22.03  
Δ=5°56'01"  
D=1°00' Lr  
T=296.93  
L=393.33  
R=5729.58

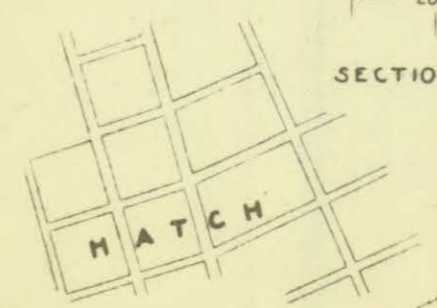

SECTION B-B

- REFERENCES
- Properties: File No.
  - Profile: Profile Map No. 26
  - Field Notes: Books 1672 (East) and 1671 and 1643 (West)
  - Minor Details: Reclamation Property Map G
  - Plane Table Sheets 23 to 27 (Incl)
  - Book 1643
  - Structures:

U.S. BUREAU OF RECLAMATION APPROVED [Signature]

INTERNATIONAL BOUNDARY COMMISSION UNITED STATES AND MEXICO UNITED STATES SECTION RIO GRANDE CANALIZATION PROJECT RINCON VALLEY ALIGNMENT, MAP NO. 26 FROM ENGR. STA. 1080+00 TO ENGR. STA. 1240+00

Drawn: J.M.M. Checked: J.M.M. Recommended: J.M.M. Approved: J.M.M. 26-18 LAS CRUCES, N.M. AUG. 16, 1930 (REV. 1931)



C 405

*Channel Lower End ~ Rincon Valley*



*Downstream View of Jundt Cut-off*




Shalem Bend ~ Looking Upstream





*Greenwood Cut-off ~ Looking Upstream*

CONSTRUCTION HEADQUARTERS

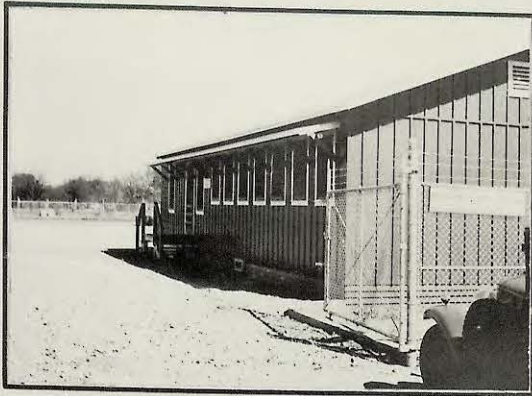

Clerical office - Las Cruces



Engineering office - Las Cruces



Flower garden - Las Cruces



Warehouse - Las Cruces



Headquarters - Hatch



Warehouse and yard - Hatch



Foreman's residence - Hatch



View of Hatch yard


CLEARING AND GRUBBING RIGHT OF WAY



Clearing right of way with tractor



Clearing right of way by hand

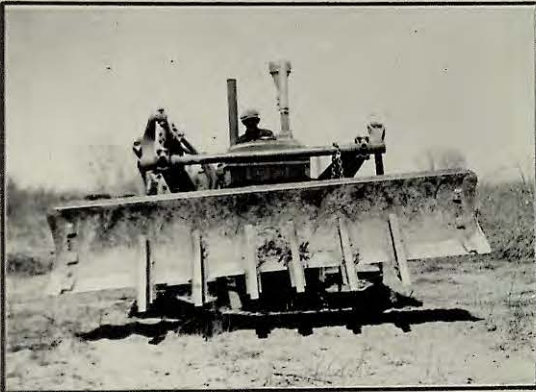


Original tractor grubber idea



Second model grubber



Second model at work

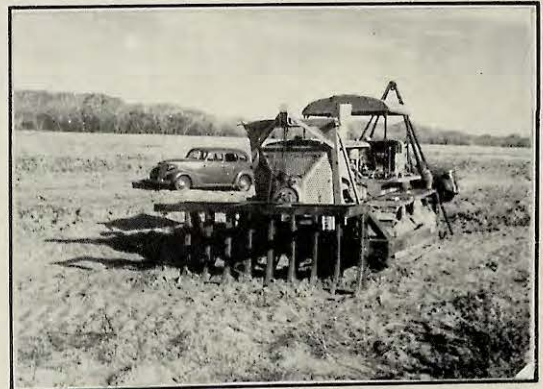

Final model

EXCAVATION - DRAGLINES


-104-




DRAGLINE No. 3 - Building levee



DRAGLINE No. 6 - Opening Jundt  
Cut-off

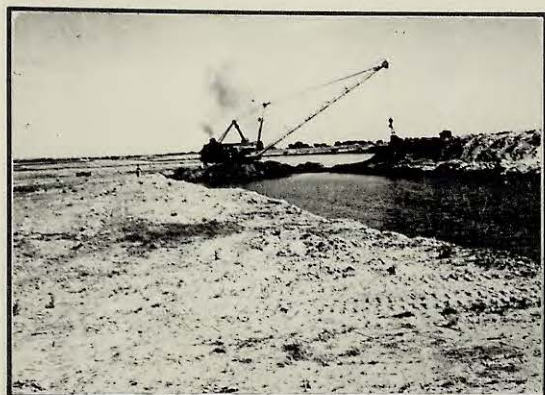

DRAGLINE No. 6 - Excavating Channel  
Cut-off

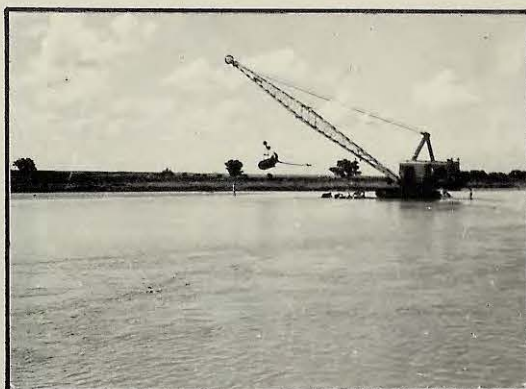

DRAGLINE No. 5 - Crossing river  
north of Berino Bridge



DRAGLINE No. 5 - Excavating Mesquite  
Cut-off



DRAGLINE No. 9 - Building levee



DRAGLINE No. 8 - Being moved across  
Hatch Highway Bridge




DRAGLINE No. 8 - Being hauled  
from Hatch to Las Cruces

EXCAVATION - TRACTORS



Carryall excavating low flow channel - Rincon Valley

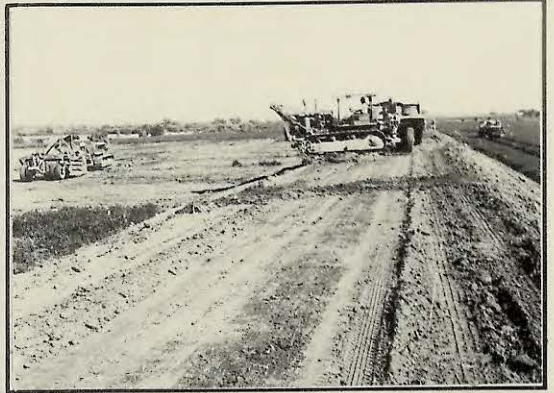

Tractors building levee - Rincon Valley



View of excavation equipment working - Mesilla Valley



Carryalls plating levee - Mesilla Valley




Tractors filling borrow pits - Mesilla Valley




Tractor filling pit near Santo Tomas Bridge - Mesilla Valley

STRUCTURES

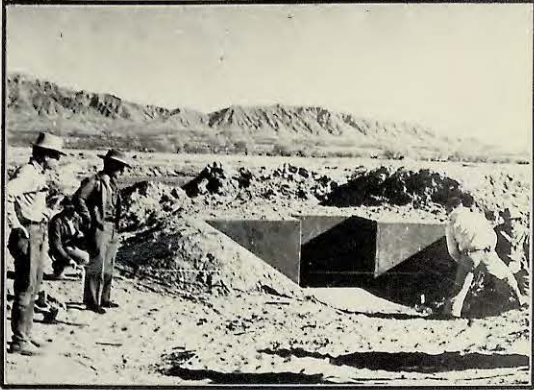

Culvert Wasteway

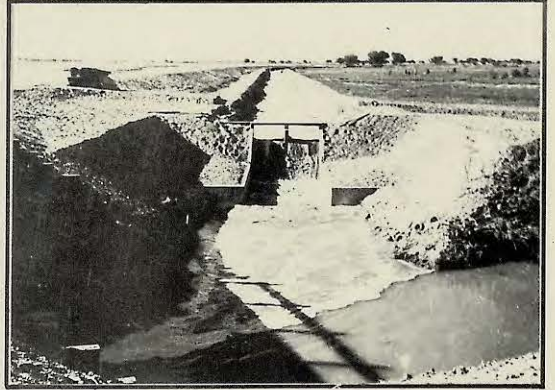


Texas Lateral Drop Wasteway



20 Ton Treated Timber Bridge



Brazito Lateral Wasteway

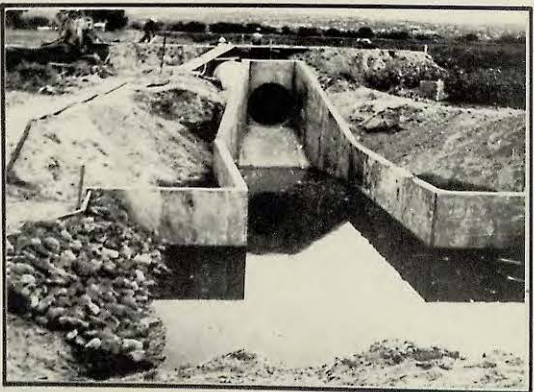

Rincon Canal Wasteway




Moving Clerical Building to Hatch

REVE TMENT



Revetment on East Levee near  
Vinton Bridge

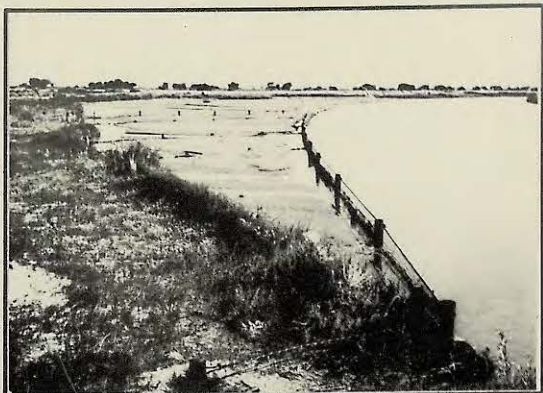


Revetment on East Levee near  
Berino Bridge



Revetment on East Levee Station  
850 - Feature 401



Crew jetting piling

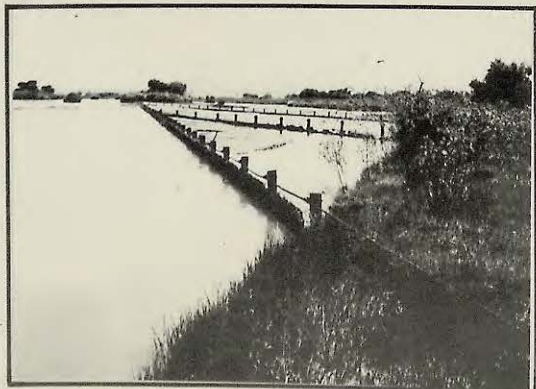

Revetment West Levee - Rincon  
Valley




Special type of revetment -  
Rincon Valley

RIO GRANDE BRIDGES




COURCHESNE BRIDGE - Heavily loaded truck breaks through bridge

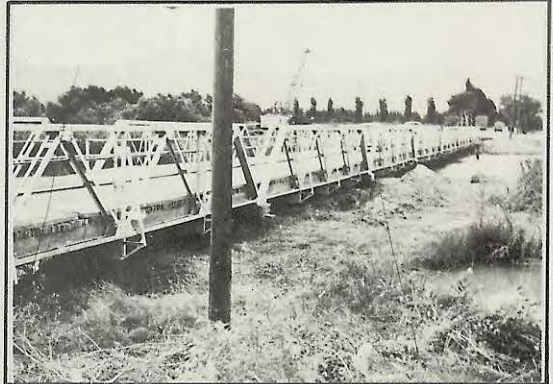

COUNTRY CLUB BRIDGE - Original




COURCHESNE BRIDGE - Construction of new concrete bridge

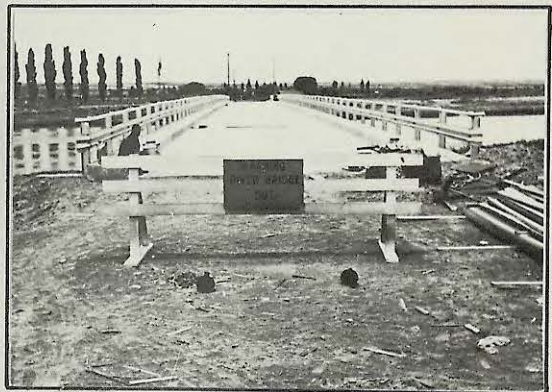

COUNTRY CLUB BRIDGE - Finished bridge



COURCHESNE BRIDGE - Finished bridge

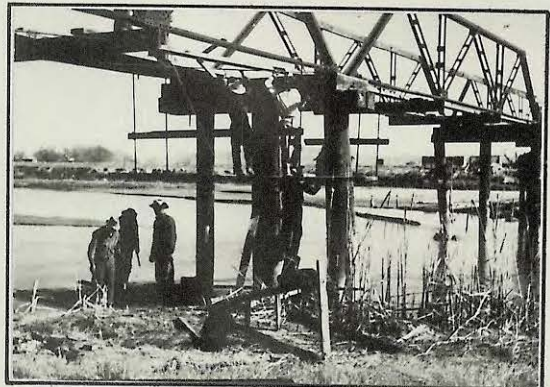

OLD ANTHONY BRIDGE - Constructed by Dona Ana County crew




RIO GRANDE BRIDGES




Testing concrete piles



OLD SHALEM BRIDGE - Original

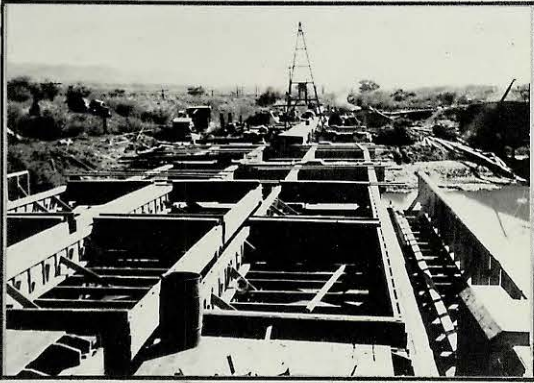


HATCH-RINCON - Bridge construction

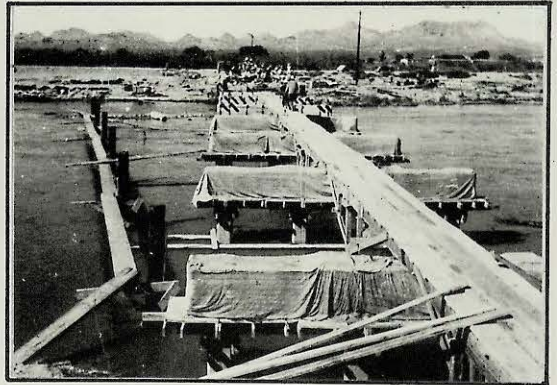

SHALEM BRIDGE - Construction  
of new concrete bridge



SALEM BRIDGE - Dona Ana County  
crew at work

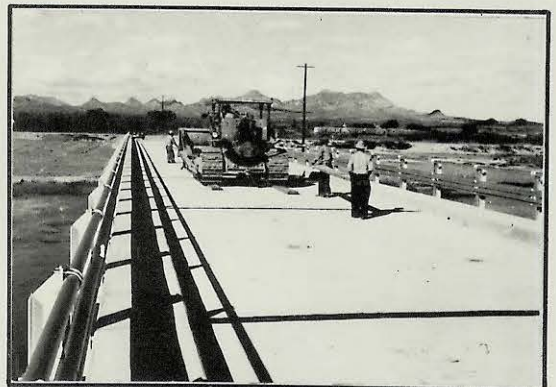

SHALEM BRIDGE - Finished bridge

COMPLETED JOB



Completed levee and channel  
near El Paso



Mesquite Cut-off Bend



Looking downstream from Station  
1090 - Feature 301



Looking downstream from Station  
650 - Feature 301



Channel Cut-off near Hill, N. M.



Looking downstream at Santo  
Tomas Bridge